

MARSHALL

F65

1-20-74

MISSISSIPPI
 BOARD OF WATER COMMISSIONERS
 416 North State Street
 Jackson, Mississippi 39201 CODED

WATER WELL DRILLERS LOG

Jan 20 1974 R. L. Carpenter Marshall
 date well completed firm name county well located

LANDOWNER: Jim Ling

Holly Springs

Miss.

(mailing address)

description of formations encountered

from to

Surface Soil

0 15

med. & fine Red sand

15 40

Red Clay

40 45

white fine sand

45 72

WELL LOCATION:

sec 15 T 2 N R 3 E
 4 miles South of Pleasant
 (distance) (direction) (nearest town)

WELL PURPOSE: Home & Farm
 (home, irrigation, municipal, industrial)

med. white sand 72 110

WELL COMPLETION DATA:

- (1) diameter (inches) 4
- (2) total depth (feet) 148
- (3) static water level (feet) 118 below top of ground.
- (4) casing Plastic 142 ft (material) (depth)

white clay 110 115

white coarse sand 115 148

CODED

(size) if telescope see back.

- (5) screen 6 ft 142 ft (length) (depth to top)

4 in. Plastico Band (size) (material)

- (6) pump 3/4 10 (HP) (yield gpm)

Elec. (type power)

- (7) electric log No. (yes or no)

(organization running log)

- (8) how well bottom plugged Plastic & Cap

DRILLERS REMARKS:


RECEIVED
 MAR 12 1974

WATER COMMISSION

MISS.

If well telescopes please sketch and show depths.

GROUND LEVEL

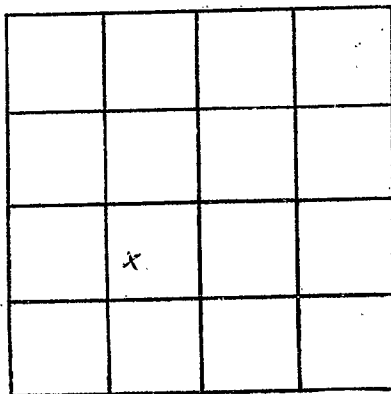

SECTION 15

Please indicate well location X.

ADDITIONAL INFORMATION

If more than one screen, show locations of each on sketch.