

MARSHALL
F 70
5-25-74

MISSISSIPPI
BOARD OF WATER COMMISSIONERS
416 North State Street
Jackson, Mississippi 39201

CODED

WATER WELL DRILLERS LOG

5-25-1974 Blicks Bore Well Co. Marshall
date well completed firm name county well located

LANDOWNER: Ellie Spight
Route 4 Box 192,
Dolly Springs, Miss.
(mailing address) 38635

description of formations encountered	from	to
	<u>Red Clay</u>	<u>0</u>
<u>White Sand</u>	<u>15</u>	<u>140</u>

WELL LOCATION:
sec 13 T 2 N R 3 E
5 miles NE Hudsonville
(distance) (direction) (nearest town)

CODED

WELL PURPOSE: Home
(home, irrigation, municipal, industrial)


- WELL COMPLETION DATA:
- (1) diameter (inches) 4 in
 - (2) total depth (feet) 140
 - (3) static water level (feet) 120 below above top of ground.
 - (4) casing Plastic 140
(material) (depth)
(size) if telescope see back.
 - (5) screen 4 ft 136
(length) (depth to top)
4 in Gravel
(size) (material)
 - (6) pump 1/2 8
(HP) (yield gpm)
220
(type power)
 - (7) electric log NO
(yes or no)
(organization running log)
 - (8) how well bottom plugged Cap

REGISTERED
JUL - 1 1974

DRILLERS REMARKS:

If well telescopes please sketch and show depths.

GROUND LEVEL

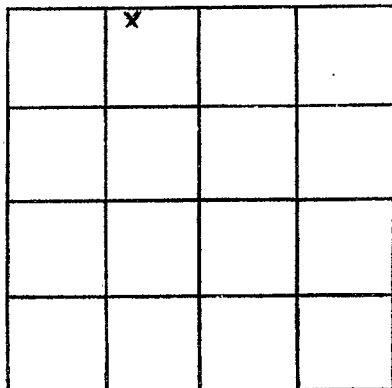

SECTION 13

Please indicate well location X.

ADDITIONAL INFORMATION

If more than one screen,
show locations of each on sketch.