

MISSISSIPPI
BOARD OF WATER COMMISSIONERS

416 North State Street
Jackson, Mississippi 39201

WATER WELL DRILLERS LOG

CODED

MARSAALL

F 71

6-3-74

6-3
date well completed

1974 DEAN Kenton Jones well
firm name

Marshall
county well located

LANDOWNER:

C. Wayne Campbell

description of formations encountered

clay

from

to

0 10

At 2 Hock Springs, Miss.
(mailing address)

Sand

10 120

WELL LOCATION:

sec. 21 T. 2 N. R. 3 E
10 miles NORTH of Hock Springs
(distance) (direction) (nearest town)

WELL PURPOSE: Domestic
(home, irrigation, municipal, industrial)

WELL COMPLETION DATA:

- (1) diameter (inches) 4"
(2) total depth (feet) 120 feet
(3) static water level (feet) 45 below above top of ground.
(4) casing PVC, 120 feet
(material) (depth)

CODED

(size) if telescope see back.

- (5) screen 7 ft., 113 feet
(length) (depth to top)

4" gravel wall
(size) (material)

- (6) pump 3/4 14
(HP) (yield/gpm)

(type power)

- (7) electric log float
(yes or no)

(organization running log)

- (8) how well bottom plugged 4" cof.


RECEIVED
MAY 15 1974

DRILLERS REMARKS:

MISS. BD. OF WATER COMMISSIONERS
MAY 15 1974

If well telescopes please sketch and show depths.

GROUND LEVEL

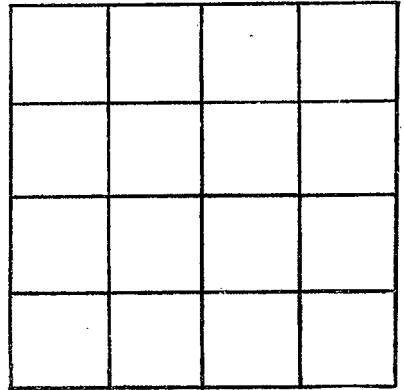

SECTION _____

Please indicate well location X.

ADDITIONAL INFORMATION

If more than one screen,
show locations of each on sketch.