

MARSHALL
FT3
3-21-75

MISSISSIPPI
 BOARD OF WATER COMMISSIONERS
 416 North State Street
 Jackson, Mississippi 39201

COPIED

WATER WELL DRILLERS LOG

3-21 1975 date well completed
 Dean & Kent Senger well firm name
 Marshall county well located

LANDOWNER:

Froy Burchette Jr.
 Rt 2, Holly Springs, Miss.
 (mailing address)

description of formations encountered

from to

clay
 sand

0 30
 30 180


WELL LOCATION:

sec. 15 T. 2 N. R. 3 E.
 10 miles SOUTH of Holly Springs
 (distance) (direction) (nearest town)

WELL PURPOSE: Dwelling
 (home, irrigation, municipal, industrial)

WELL COMPLETION DATA:

- (1) diameter (inches) 4"
- (2) total depth (feet) 180 feet
- (3) static water level (feet) 130 ft. below top of ground.
- (4) casing PVC, 180 feet (material) (depth)
- (size) if telescope see back.
- (5) screen 7 ft., 123 feet (length) (depth to top)
- 4" gravel wall (size) (material)
- (6) pump 3/4 HP, 14 (yield gpm)
- (type power)
- (7) electric log Electric (yes or no)
- (organization running log)
- (8) how well bottom plugged 4" cap.

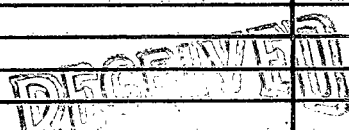


APR - 7 1975

DRILLERS REMARKS:

MISS. BD. OF WATER COMMISSIONERS

If well telescopes please sketch and show depths.

GROUND LEVEL

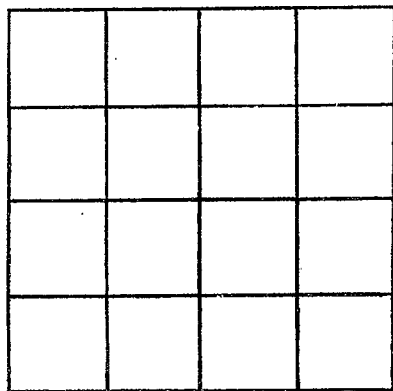

SECTION _____

Please indicate well location X.

ADDITIONAL INFORMATION

If more than one screen,
show locations of each on sketch.