

Marshall
 F 74
 5-13-75

MISSISSIPPI
 BOARD OF WATER COMMISSIONERS
 416 North State Street
 Jackson, Mississippi 39201

CODED

WATER WELL DRILLERS LOG

May 13 1975 Billy R. Simpson MARSHALL
 date well completed firm name county well located

LANDOWNER:	description of formations encountered	from	to
MRS CHAS. COOK			
Holly SPRINGS - MS (mailing address)	FINE SAND + WHITE CLAY	16	60
	COARSE SAND	60	88

WELL LOCATION:
 sec. 35 T 2 N R 2 E 156
 S W
 7 miles N of Holly Sps.
 (distance) (direction) (nearest town)

WELL PURPOSE: HOME
 (home, irrigation, municipal, industrial)

- WELL COMPLETION DATA:
- (1) diameter (inches) 4
 - (2) total depth (feet) 88
 - (3) static water level (feet) 60 below top of ground.
 - (4) casing POC 82
 (material) (depth)
 - (size) if telescope see back.
 - (5) screen 6' 82
 (length) (depth to top)
 - (size) (material)
 4 POC
 - (6) pump 1/3 4
 (HP) (yield gpm)
 - Elec
 (type power)
 - (7) electric log NO
 (yes or no)
 - (organization running log)
 - (8) how well bottom plugged POC
 CAP


DRILLERS REMARKS:

RECEIVED
 JUN 11 1975

MISS. RD. OF WATER COMMISSIONERS

If well telescopes please sketch and show depths.

GROUND LEVEL

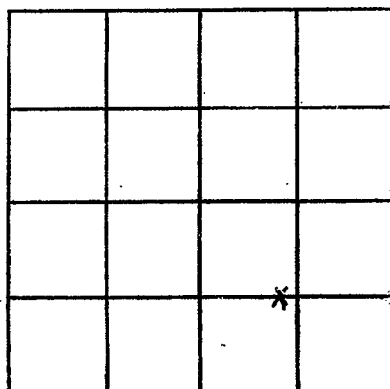

SECTION 35

Please indicate well location X.

ADDITIONAL INFORMATION

If more than one screen,
show locations of each on sketch.