

Marshall  
F 75  
6-17-75

MISSISSIPPI  
BOARD OF WATER COMMISSIONERS  
416 North State Street  
Jackson, Mississippi 39201

CODED

WATER WELL DRILLERS LOG

6-17 1975 date well completed  
Dean & Kent Burfoot firm name  
Marshall county well located

LANDOWNER:

description of formations encountered

from to

W. D. Aaron  
RT. 2  
Holly Springs, Miss  
(mailing address)

clay

0 20

WELL LOCATION:

sec. 36 T. 2 N. R. 3 E.  
#26 miles North of Holly Springs  
(distance) (direction) (nearest town)

sand

20 50

clay

50 60

sand

60 130

CODED

WELL PURPOSE: Drilling  
(home, irrigation, municipal, industrial)

WELL COMPLETION DATA:

- (1) diameter (inches) 4"
- (2) total depth (feet) 130 feet
- (3) static water level (feet) 60 feet below top of ground.
- (4) casing PVC, 130 feet (material) (depth)  
(size) If telescope see back.
- (5) screen 7 ft, 123 feet (length) (depth to top)  
4" small wolf (size) (material)
- (6) pump 3/4 14 (HP) (yield gpm)  
(type power)
- (7) electric log Elect. (yes or no)  
(organization running log)
- (8) how well bottom plugged 4" cap.


REGISTERED  
JUL 11 1975

DRILLERS REMARKS:

MISS. Bd. OF WATER COMMISSIONERS

If well telescopes please sketch and show depths.

GROUND LEVEL

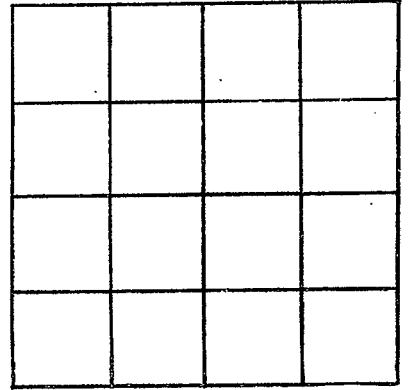

SECTION \_\_\_\_\_

Please indicate well location X.

ADDITIONAL INFORMATION

If more than one screen, show locations of each on sketch.