

### State Well Report Part 1 - Driller's Log

Mississippi Department of Environmental Quality  
Office of Land and Water Resources  
P.O. Box 10631  
Jackson, MS 39289-0631  
(601)961-5210  
(601)354-6938 (fax)

County: Marshall  
 Permit #: D-162  
 Driller: Larry Carpenter  
 Date drilling completed: 1-29-07

For Office Use Only:  
 Aquifer: \_\_\_\_\_  
 Well #: F-111  
 L. S. Elevation: \_\_\_\_\_  
 E-log #: \_\_\_\_\_

State Law requires that this report be prepared by the license holder responsible for the work and filed with the Department at the above address within 30 days of completion of drilling of the well or borehole.

<b>Information on Well Owner</b> <i>(Landowner if borehole is not for a water well)</i> Owner Name: <u>Phil Han</u> Mailing Address: <u>6841 Hwy 311</u> <u>Holly Springs Ms. 38635</u> City State Zip Code Telephone No. <u>(662) 851-7238</u>	<b>Well or Borehole Location</b> Latitude: <u>34° 55' 29"</u> Longitude: <u>89° 30' 45"</u> Method of Lat/Long (circle one): Conventional Survey, USGS quad, Hand-held GPS, Survey-grade GPS <u>NE ¼ SE ¼ Sec 9 Twn 25 Rng 34</u> Distance Direction Nearest Town <u>1 1/2 Miles South of Mt. Pleasant</u>
---	--

**Well / Borehole Data**

Date drilling started: 1-29-07 Date drilling completed: 1-29-07 Hole depth: 140' Hole diameter: 8"

Location of the source of any surface water used for drilling: Well Water  
 Method of dosing and volume of Chlorine used in drilling and development: 1/2 Pt Chlorine to 100' Det Water

Logs run (circle all applicable): No log run Electric Gamma Ray Density Sonic Neutron Other: \_\_\_\_\_  
 Name of organization running log(s): \_\_\_\_\_

Purpose of borehole (check one): Water Well  Geotechnical/Geological Investigation \_\_\_\_\_ Ground Source Heat Pump \_\_\_\_\_  
 Seismic Survey \_\_\_\_\_ Other (describe) \_\_\_\_\_  
*If drilling is not related to water well construction, skip the remainder of this block*

Purpose of Well (check one): Home  Industrial \_\_\_\_\_ Public Supply \_\_\_\_\_ Irrigation \_\_\_\_\_ Fish Culture \_\_\_\_\_ Other: \_\_\_\_\_

If a flowing well, method of flow regulation: Valve \_\_\_\_\_ Other (describe) \_\_\_\_\_

Static Water Level: 85 feet above or below (circle one) land surface Date measured: 1-29-07

Method of Measurement (circle one) steel tape electric tape air line other: \_\_\_\_\_

Well depth: 140' Well grouted to a depth of 10 feet Type of grout (circle one) Neat Cement Bentonite Mix  
 Casing length: 130 feet Casing diameter: 4 inches Type of casing: PVC  
 Screen length: 10 feet Screen diameter: 4 inches Type of screen: PVC  
 Screen slot size: .013 inches Setting depth: From 130 feet to 140 feet

Type of completion (circle all applicable): Gravel packed Underreamed Telescoped Open hole Natural Development  
 Other (describe): \_\_\_\_\_


Top of lap pipe or reduction in casing: \_\_\_\_\_ feet. *If telescoped or more than one screen, describe on next page*


Form: OLWR-SWR-1A

RECEIVED  
FEB 22 2007  
BY: OLWR

F-111

The sketch below only required for water wells

If well telescopes, show depths on sketch.  
Ground Level. 

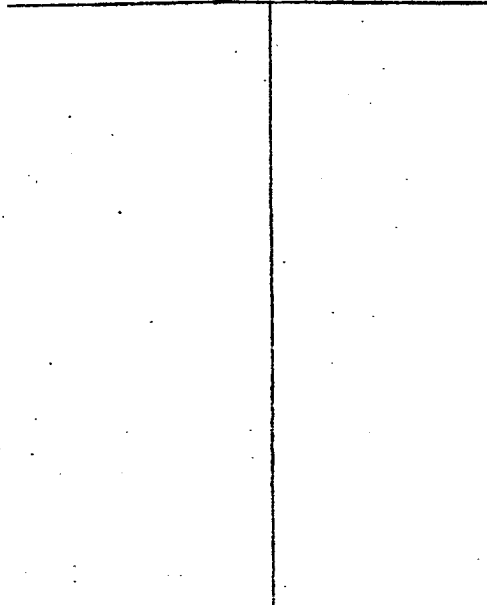


Description of formations encountered must be provided for all wells and boreholes, unless specifically exempted by regulations

Description of Formations Encountered	From (depth) Ground Level!	To (depth)
Surface Soil	0	24
Med. Red Sand	24	45
Med White Sand	45	70
White Clay	70	85
Fine White Sand	85	104
Coarse White Sand	104	140

If more than one screen, show location of each on sketch

Sketch the property layout and include the following: 1) the well location; 2) any permanent structures on the property that may aid in locating the well; 3) any roads, power lines, or other items that may aid in locating the property and the well; 4) a north arrow.

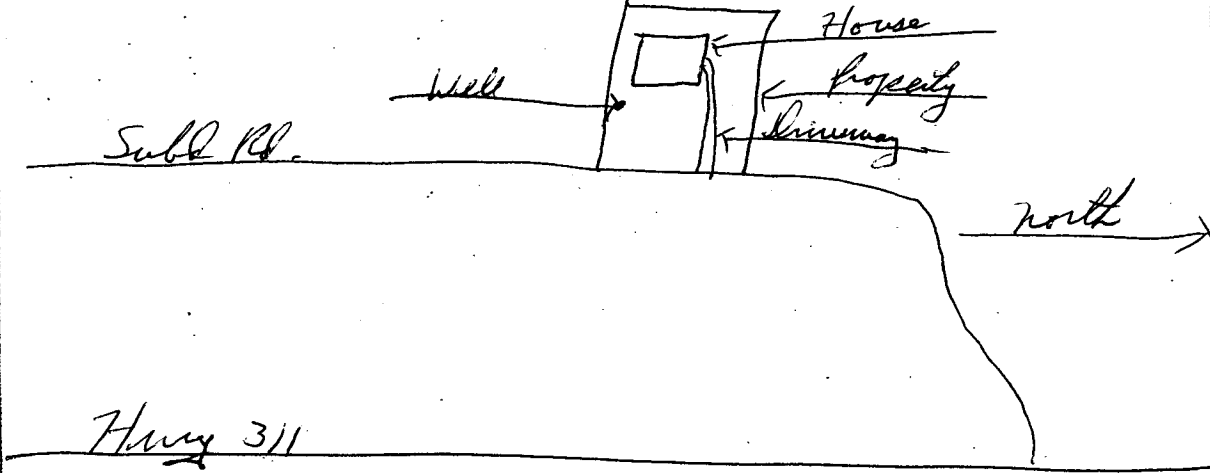

Hwy 311

Landowner Name: Phil Kan

Form: OLWR-SWR-1A

I certify that the well/borehole was drilled, constructed, and completed in accordance with all applicable requirements of the Mississippi Department of Environmental Quality and the Mississippi Department of Health regulations, if applicable, and state laws.

LARRY CARPENTER 0-162 1-31-07  
Print Name of Responsible Licensee and License No. Date

Larry Carpenter  
Signature of Licensee

RECEIVED  
FEB 22 2007  
BY: OLWR

### STATE WELL REPORT

#### Part 2

Pump Installer's Completion Report  
 Mississippi Department of Environmental Quality  
 Office of Land and Water Resources  
 P.O. Box 10631  
 Jackson, MS 39289-0631  
 (601)961-5210  
 (601)354-6938 (fax)

County: Marshall  
 Permit #: 0-162  
 Driller: Larry Carpenter  
 Date completed: 1-29-07  
 Copy information from block on Part 1

For Office Use Only:  
 Aquifer: \_\_\_\_\_  
 Well #: F-111  
 Elevation: \_\_\_\_\_

This part of the report must be completed by a licensed water well contractor or a licensed pump installer. A copy of Part 1 of the report must be attached and both parts filed with the Department at the above address within 30 days of well completion.

Well Owner Information	Well Location
Owner Name: <u>Phil Kan</u>	Latitude: _____ Longitude: _____
Mailing Address: <u>6841 Hwy 311</u>	Method of Lat/Long (check one): Conventional Survey _____
<u>Holly Springs Ms. 38635</u>	USGS quad _____ Hand-held GPS _____ Survey-grade GPS _____
City State Zip Code	<u>1/4 1/4 Sec 9 T 25 R 36</u>
Telephone No. <u>(662) 851-7238</u>	Distance Direction Nearest Town
	<u>1 1/2 Miles South of Mt. Pleasant</u>

Pump Type Circle one	Power Type Circle one
Air Lift <input type="checkbox"/> Jet <input type="checkbox"/> <u>Submersible</u>	Diesel Engine <input type="checkbox"/> Gasoline Engine <input type="checkbox"/> Natural Gas <input type="checkbox"/>
Bucket <input type="checkbox"/> Piston <input type="checkbox"/> Turbine <input type="checkbox"/>	<u>Electric Motor</u> <input type="checkbox"/> Hand <input type="checkbox"/> Tractor PTO <input type="checkbox"/>
Centrifugal <input type="checkbox"/> Rotary <input type="checkbox"/> Flowing Well <input type="checkbox"/>	Windmill <input type="checkbox"/> Other (specify): _____
Other (specify): _____	Horse Power Rating of Motor: <u>3/4</u>
Date Pump Installed: <u>1-29-07</u>	Setting Depth: <u>110</u> feet
Rated Pump Capacity: <u>10</u> Gallons Per Minute	Number of Stages: <u>11</u>

Pump Test Data	Method of Measuring Water Level Circle one
Date Well Tested: <u>1-29-07</u>	Air Line <input type="checkbox"/> Electric Measuring Line <input type="checkbox"/> <u>Steel Tape</u>
Static Water Level (A): <u>85</u> Feet Below Land Surface	Other (specify): _____
Pumping Water Level (B): <u>90</u> Feet Below Land Surface	For flowing well, measured shut in head: _____ feet
Drawdown ((B) - (A)): <u>5</u> Feet Below Land Surface	Well yielded <u>16</u> GPM with a drawdown of
Test Pumping Rate: <u>16</u> Gallons Per Minute	<u>5</u> feet after <u>4</u> hours of pumping
Duration of Pump Test (minimum 4 hours): <u>4</u> hours	

I HEREBY CERTIFY that the above statements are true to the best of my knowledge.  
LARRY CARPENTER 0-162 Larry Carpenter  
 Print Name of Pump Installer and License No. (if applicable) Signature of Pump Installer

Form: OLWR-SWR-1B

RECEIVED  
 FEB 22 2007  
 BY: OLWR