

County: Marshall  
 Permit #: 8-162  
 Driller: Larry Cooper  
 Date drilling completed: 6-15-06

**State Well Report**  
**Part 1 - Driller's Log**  
 Mississippi Department of Environmental Quality  
 Office of Land and Water Resources  
 P.O. Box 10631  
 Jackson, MS 39289-0631  
 (601)961-5210  
 (601)354-6938 (fax)

For Office Use Only:  
 Aquifer: \_\_\_\_\_  
 Well #: B-96 F-124  
 L.S. Elevation: \_\_\_\_\_  
 E-log #: \_\_\_\_\_

State Law requires that this report be prepared by the license holder responsible for the work and filed with the Department at the above address within 30 days of completion of drilling of the well or borehole.

**Information on Well Owner**  
 (Landowner if borehole is not for a water well)  
 Owner Name: Southern Home  
 Mailing Address: 420 East Van Horn Ave  
Holly Springs No. 38635  
 City State Zip Code  
 Telephone No. (662) 252-3497

**Well or Borehole Location**  
 Latitude: 34° 55.52' Longitude: 89° 30.09'  
 Method of Lat/Long (circle one): Conventional Survey  
 USGS quad, Hand-held GPS, Survey-grade GPS  
NE 1/4 NW 1/4 Sec 10 Twn 25 Rng 3W  
 Distance Direction Nearest Town  
1 1/2 Miles South of Mt. Pleasant

**Well / Borehole Data**  
 Date drilling started: 6-15-06 Date drilling completed: 6-15-06 Hole depth: 150' Hole diameter: 8"  
 Location of the source of any surface water used for drilling: Well Water  
 Method of dosing and volume of Chlorine used in drilling and development: 1/2 Pt Chlorine to 1000 Gal Water  
 Logs run (circle all applicable): No log run Electric Gamma Ray Density Sonic Neutron Other: \_\_\_\_\_  
 Name of organization running log(s): \_\_\_\_\_  
 Purpose of borehole (check one): Water Well  Geotechnical/Geological Investigation \_\_\_\_\_ Ground Source Heat Pump \_\_\_\_\_  
 Seismic Survey \_\_\_\_\_ Other (describe) \_\_\_\_\_  
 If drilling is not related to water well construction, skip the remainder of this block.

Purpose of Well (check one): Home  Industrial \_\_\_\_\_ Public Supply \_\_\_\_\_ Irrigation \_\_\_\_\_ Fish Culture \_\_\_\_\_ Other: \_\_\_\_\_  
 If a flowing well, method of flow regulation: Valve \_\_\_\_\_ Other (describe) \_\_\_\_\_  
 Static Water Level: 85 feet above or below (circle one) land surface Date measured: 6-15-06  
 Method of Measurement (circle one) Steel tape electric tape air line other: \_\_\_\_\_  
 Well depth: 150' Well grouted to a depth of 10 feet Type of grout (circle one): Neat Cement Bentonite Mix  
 Casing length: 140 feet Casing diameter: 4 inches Type of casing: PVC  
 Screen length: 10 feet Screen diameter: 4 inches Type of screen: PVC  
 Screen slot size: 0.13 inches Setting depth: From 140 feet to 150 feet  
 Type of completion (circle all applicable): Gravel packed Underreamed Telescoped Open hole Natural Development  
 Other (describe): \_\_\_\_\_  
 Top of lap pipe or reduction in casing: \_\_\_\_\_ feet. If telescoped or more than one screen, describe on next page.


Form OLWR-10  
**RECEIVED**  
 JUL 10 2006  
 BY: OLWR

B-76  
F-124

The sketch below only required for water wells

If well telescopes, show depths on sketch.

Ground Level EL

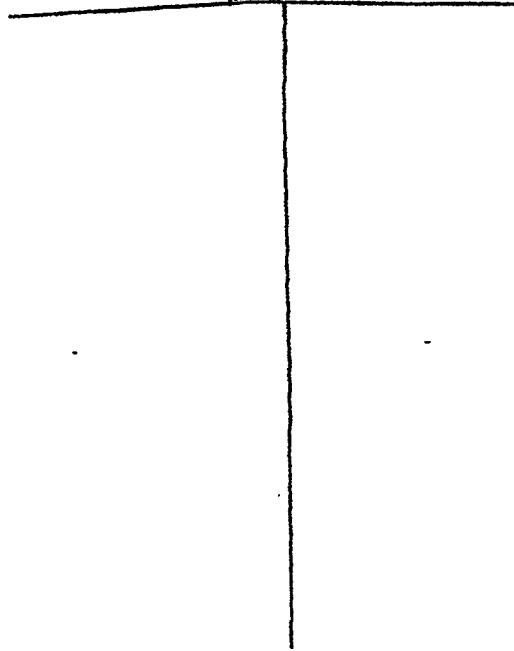


Description of formations encountered must be provided for all wells and boreholes, unless specifically exempted by regulations

Description of Formations Encountered	From (depth)	To (depth)
Surface Soil	Ground Level	
	0	21
Med. Red Soil	21	42
Med. & Fine White Soil	42	75
White Clay	75	95
Med. White Soil	95	120
White loose Soil	120	150

If more than one screen, show location of each on sketch

Sketch the property layout and include the following: 1) the well location; 2) any permanent structures on the property that may aid in locating the well; 3) any roads, power lines, or other items that may aid in locating the property and the well; 4) a north arrow.

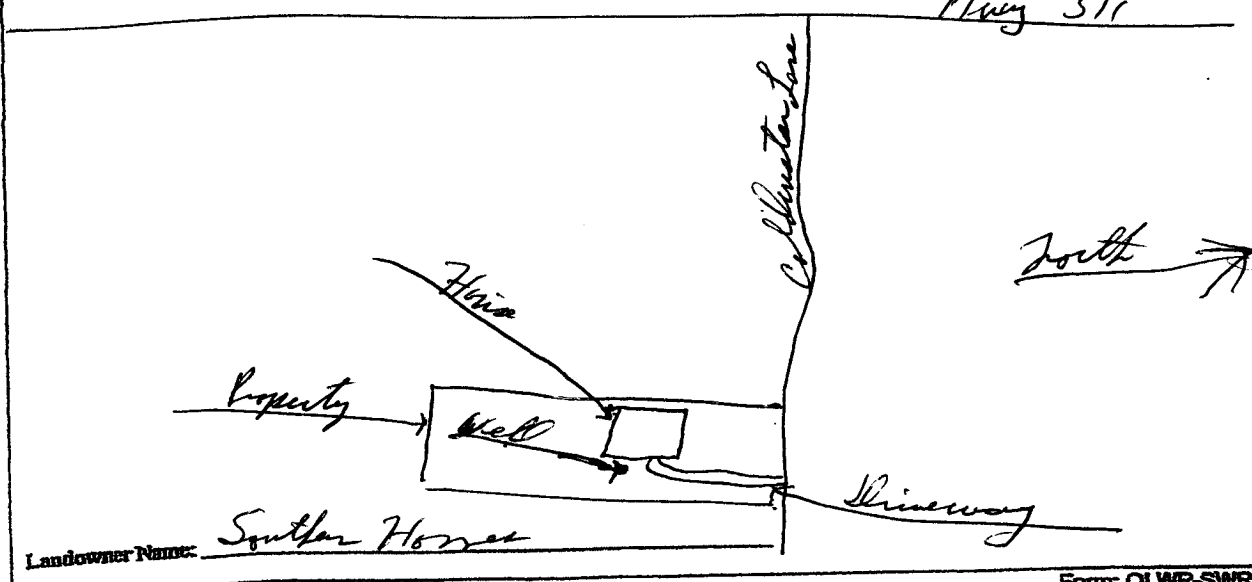

Landowner Name: Soutlar Homes

I certify that the well/borehole was drilled, constructed, and completed in accordance with all applicable requirements of the Mississippi Department of Environmental Quality and the Mississippi Department of Health regulations, if applicable, and all laws.

Print Name of Responsible Licensee and License No. LARRY CARPENTER 0162

Date 6-22-06

Signature of Licensee Larry Carpenter

Form: OLWR-SWR-1A

RECEIVED  
JUL 18 2006  
BY: OLWR

# STATE WELL REPORT

## Part 2

Pump Installer's Completion Report  
Mississippi Department of Environmental Quality  
Office of Land and Water Resources  
P.O. Box 10631  
Jackson, MS 39289-0631  
(601)961-5210  
(601)354-6938 (fax)

County: Marshall  
 Permit #: 0-162  
 Driller: Larry Carpenter  
 Date completed: 6-15-06  
*Copy information from block on Part 1*

For Office Use Only:

Aquifer: \_\_\_\_\_  
 Well #: B-76 F-124  
 Elevation: \_\_\_\_\_

*This part of the report must be completed by a licensed water well contractor or a licensed pump installer. A copy of Part 1 of the report must be attached and both parts filed with the Department at the above address within 30 days of well completion.*

Well Owner Information	Well Location
Owner Name: <u>Southern Homes</u>	Latitude: _____ Longitude: _____
Mailing Address: <u>420 East Van Horn ave</u>	Method of Lat/Long (check one): Conventional Survey _____
<u>Holly Springs</u> Mo. <u>38635</u>	USGS quad _____, Hand-held GPS _____, Survey-grade GPS _____
City State Zip Code	_____ 1/4 _____ 1/4 Sec. <u>10</u> T <u>15</u> R <u>3W</u>
Telephone No. <u>(662) 252-3497</u>	Distance Direction Nearest Town
	<u>1 1/2</u> Miles <u>South</u> of <u>Mt. Pleasant</u>

Pump Type Circle one	Power Type Circle one
Air Lift Jet <input checked="" type="radio"/> <u>Submersible</u>	Diesel Engine Gasoline Engine Natural Gas
Bucket Piston Turbine	<input checked="" type="radio"/> <u>Electric Motor</u> Hand Tractor PTO
Centrifugal Rotary Flowing Well	Windmill Other (specify): _____
Other (specify): _____	Horse Power Rating of Motor: <u>3/4</u>
Date Pump Installed: <u>6-15-06</u>	Setting Depth: <u>120</u> feet
Rated Pump Capacity: <u>10</u> Gallons Per Minute	Number of Stages: <u>11</u>

Pump Test Data	Method of Measuring Water Level Circle one
Date Well Tested: <u>6-15-06</u>	Air Line Electric Measuring Line <input checked="" type="radio"/> <u>Steel Tape</u>
Static Water Level (A): <u>85</u> Feet Below Land Surface	Other (specify): _____
Pumping Water Level (B): <u>90</u> Feet Below Land Surface	For flowing well, measured shut in head: _____ feet
Drawdown [(B)-(A)]: <u>5</u> Feet Below Land Surface	Well yielded <u>16</u> GPM with a drawdown of
Test Pumping Rate: <u>16</u> Gallons Per Minute	<u>5</u> feet after <u>4</u> hours of pumping
Duration of Pump Test (minimum 4 hours): <u>4</u> hours	

I HEREBY CERTIFY that the above statements are true to the best of my knowledge.

LARRY CARPENTER 0-162  
 Print Name of Pump Installer and License No. (if applicable)

Larry Carpenter  
 Signature of Pump Installer

Form: OLWRSIF-125

RECEIVED  
 JUL 10 2006  
 BY: OLWR