

County: Marshall
 Permit #: ~~16388~~ 16388
 Driller: Larry Carpenter
 Date drilling completed: 4-10-07

State Well Report
Part 1 - Driller's Log
 Mississippi Department of Environmental Quality
 Office of Land and Water Resources
 P.O. Box 10631
 Jackson, MS 39289-0631
 (601)961-5210
 (601)354-6938 (fax)

For Office Use Only:
 Aquifer: _____
 Well #: F-133
 L. S. Elevation: _____
 E-log #: _____

State Law requires that this report be prepared by the license holder responsible for the work and filed with the **MDEQ** Department at the above address within 30 days of completion of drilling of the well or borehole.

<p>Information on Well Owner (Landowner if borehole is not for a water well) Owner Name: <u>Frederick W. Smith</u> Mailing Address: <u>1805 Atway Rd.</u> <u>Holly Springs, Ms 38435</u> City State Zip Code Telephone No. () _____</p>	<p>Well or Borehole Location Latitude: <u>31° 53' 04"</u> Longitude: <u>89° 28' 05"</u> Method of Lat/Long (circle one): Conventional Survey, <input checked="" type="checkbox"/> USGS quad, <input checked="" type="checkbox"/> Hand-held GPS, <input checked="" type="checkbox"/> Survey-grade GPS <u>SE 1/4 NW 1/4 Sec 25 Twn 025 Rng 03W</u> Distance Direction Nearest Town <u>4 1/2</u> Miles <u>SW</u> of <u>Snyder</u></p>
---	---

Well / Borehole Data

Date drilling started: 4-10-07 Date drilling completed: 4-10-07 Hole depth: 165' Hole diameter: 10"

Location of the source of any surface water used for drilling: _____
 Method of dosing and volume of Chlorine used in drilling and development: 1 lb Chlorine to 1000 Gal. Water

Logs run (circle all applicable): No log run Electric Gamma Ray Density Sonic Neutron Other: _____
 Name of organization running log(s): _____

Purpose of borehole (check one): Water Well Geotechnical/Geological Investigation _____ Ground Source Heat Pump _____
 Seismic Survey _____ Other (describe) _____
If drilling is not related to water well construction, skip the remainder of this block

Purpose of Well (check one): Home _____ Industrial _____ Public Supply _____ Irrigation Fish Culture _____ Other: Livestock

If a flowing well, method of flow regulation: Valve _____ Other (describe) _____

Static Water Level: 58 feet above or below (circle one) land surface Date measured: 4-11-07

Method of Measurement (circle one) steel tape electric tape air line other: _____

Well depth: 165' Well grouted to a depth of 10 feet Type of grout (circle one) Neat Cement Bentonite Mix

Casing length: 85 feet Casing diameter: 6 inches Type of casing: PVC

Screen length: 80 feet Screen diameter: 6 inches Type of screen: PVC

Screen slot size: .013 inches Setting depth: From 85 feet to 160 feet

Type of completion (circle all applicable): Gravel packed Underreamed Telescoped Open hole Natural Development
 Other (describe): _____


Top of lap pipe or reduction in casing: _____ feet *If telescoped or more than one screen, describe on next page*

RECEIVED
 MAY 04 2007
 BY: OLWR

F-133

The sketch below only required for water wells


If well telecases show depths on sketch
Ground Level →

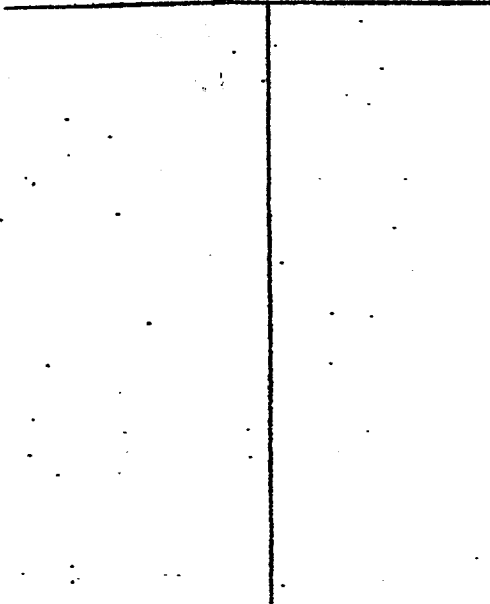

Description of formations encountered must be provided for all wells and formations unless specifically contacted by ~~responsible~~

Description of Formations Encountered	From (depth) To (depth)	
	Ground Level	
Surface Soil -	0	18
Red Red & White Sand	18	40
White Red Sand	40	65
White Clay	65	70
White Coarse Sand -	70 -	165

If more than one screen, show location of each on sketch

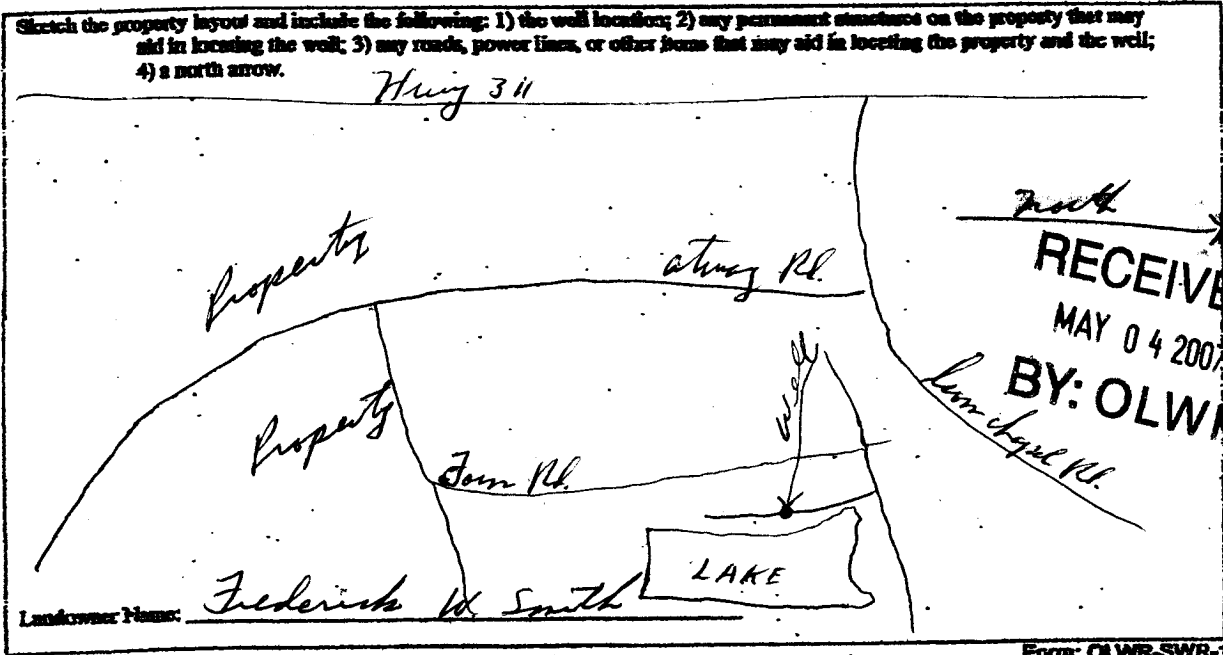

Form: OLWR-SWR-1A

I certify that the well/borehole was drilled, constructed, and completed in accordance with all applicable requirements of the Mississippi Department of Environmental Quality and the Mississippi Department of Health regulations, if applicable, and state laws.

LARRY CARPENTER 0-162 4-26-07 Larry Carpenter
Print Name of Responsible Licensee and License No. Date Signature of Licensee

STATE WELL REPORT

Part 2

Pump Installer's Completion Report
 Mississippi Department of Environmental Quality
 Office of Land and Water Resources
 P.O. Box 10631
 Jackson, MS 39289-0631
 (601)961-5210
 (601)354-6938 (fax)

County: Marshall
 Permit #: 0-162
 Driller: Larry Carpenter
 Date completed: 4-12-07
Copy information from block on Part 1

For Office Use Only:

Aquifer: _____
 Well #: F-133
 Elevation: _____

This part of the report must be completed by a licensed water well contractor or a licensed pump installer. A copy of Part 1 of the report must be attached and both parts filed with the Department at the above address within 30 days of well completion.

Well Owner Information	Well Location
Owner Name: <u>Frederick W. Smith</u>	Latitude: _____ Longitude: _____
Mailing Address: <u>1805 Atway Rd.</u>	Method of Lat/Long (check one): Conventional Survey _____ USGS quad _____ Hand-held GPS _____ Survey-grade GPS _____
<u>Holly Springs, Ms. 38637</u>	<u>SE 1/4 NW 1/4 Sec 25 T 025 R 03W</u>
City State Zip Code	Distance Direction Nearest Town
Telephone No. <u>(901) 299-8980</u>	<u>4 1/2 Miles SW of Sloyden</u>

Pump Type Circle one	Power Type Circle one
Air Lift <input type="checkbox"/> Jet <input type="checkbox"/> Submersible <input checked="" type="checkbox"/>	Diesel Engine <input type="checkbox"/> Gasoline Engine <input type="checkbox"/> Natural Gas <input type="checkbox"/>
Bucket <input type="checkbox"/> Piston <input type="checkbox"/> Turbine <input type="checkbox"/>	Electric Motor <input checked="" type="checkbox"/> Hand <input type="checkbox"/> Tractor <input type="checkbox"/>
Centrifugal <input type="checkbox"/> Rotsry <input type="checkbox"/> Flowing Well <input type="checkbox"/>	Windmill <input type="checkbox"/> Other (specify): _____
Other (specify): _____	Horse Power Rating of Motor: <u>15</u>
Date Pump Installed: <u>4-12-07</u>	Setting Depth: <u>105</u> feet
Rated Pump Capacity: <u>350</u> Gallons Per Minute	Number of Stages: <u>3</u>

RECEIVED
 MAY 04 2007
 BY: OLWR

Pump Test Data	Method of Measuring Water Level Circle one
Date Well Tested: <u>4-12-07</u>	Air Line <input type="checkbox"/> Electric Measuring Line <input type="checkbox"/> Steel Tape <input checked="" type="checkbox"/>
Static Water Level (A): <u>58</u> Feet Below Land Surface	Other (specify): _____
Pumping Water Level (B): <u>68</u> Feet Below Land Surface	For flowing well, measured shut in head: _____ feet
Drawdown [(B) - (A)]: <u>10</u> Feet Below Land Surface	Well yielded <u>350</u> GPM with a drawdown of
Test Pumping Rate: <u>350</u> Gallons Per Minute	<u>10</u> feet after <u>6</u> hours of pumping
Duration of Pump Test (minimum 4 hours): <u>6</u> hours	

I HEREBY CERTIFY that the above statements are true to the best of my knowledge.

LARRY CARPENTER 0-162 Larry Carpenter
 Print Name of Pump Installer and License No. (if applicable) Signature of Pump Installer