

County: Marshall
 Permit #: 0-162
 Driller: Larry Carpenter
 Date drilling completed: 5-28-07

State Well Report
Part 1 - Driller's Log
 Mississippi Department of Environmental Quality
 Office of Land and Water Resources
 P.O. Box 10631
 Jackson, MS 39289-0631
 (601)961-5210
 (601)354-6938 (fax)

For Office Use Only:
 Aquifer: _____
 Well #: B-67 F158
 L. S. Elevation: _____
 E-log #: _____

State Law requires that this report be prepared by the license holder responsible for the work and filed with the Department at the above address within 30 days of completion of drilling of the well or borehole.

Information on Well Owner (Landowner if borehole is not for a water well)	Well or Borehole Location
Owner Name: <u>Scotter Homer</u>	Latitude: <u>34° 55' 42"</u> Longitude: <u>89° 30' 23"</u>
Mailing Address: <u>P.O. Box 5172</u>	Method of Lat/Long (circle one): <u>Conventional Survey</u>
<u>Holly Springs</u> City <u>MS</u> State <u>38634</u> Zip Code	USGS quad, Hand-held GPS, Survey-grade GPS <u>SW 4 N W 4 Sec 10 Twn 25 Rng 3 N</u>
Telephone No. <u>(662) 252-3497</u>	Distance <u>1 1/2</u> Miles Direction <u>South</u> of Nearest Town <u>7th Pleasant</u>

Well / Borehole Data

Date drilling started: 5-28-07 Date drilling completed: 5-28-07 Hole depth: 140' Hole diameter: 9"

Location of the source of any surface water used for drilling: Well Water

Method of dosing and volume of Chlorine used in drilling and development: 1/2 P.P. Chlorine to 1000 Gall Water

Logs run (circle all applicable): No log run Electric Gamma Ray Density Sonic Neutron Other: _____

Name of organization running log(s): _____

Purpose of borehole (check one): Water Well Geotechnical/Geological Investigation _____ Ground Source Heat Pump _____

Seismic Survey _____ Other (describe) _____

If drilling is not related to water well construction, file the remainder of this block

Purpose of Well (check one): Home Industrial _____ Public Supply _____ Irrigation _____ Fish Culture _____ Other _____

If a flowing well, method of flow regulation: Valve _____ Other (describe) _____

Static Water Level: 80 feet above or below (circle one) land surface Date measured: 5-28-07

Method of Measurement (circle one) steel tape electric tape air line other: _____

Well depth: 140' Well grouted to a depth of 10 feet Type of grout (circle one): Neat Cement Bentonite Mix

Casing length: 130 feet Casing diameter: 4 inches Type of casing: PVC

Screen length: 10 feet Screen diameter: 4 inches Type of screen: PVC

Screen slot size: .013 inches Setting depth: From 130 feet to 140 feet

Type of completion (circle all applicable): Gravel packed Underreamed Telescoped Open hole Natural Development

Other (describe): _____

Top of lap pipe or reduction in casing: _____ feet *If telescoped or more than one screen, describe on next page*

STATE WELL REPORT

Part 2

Pump Installer's Completion Report
Mississippi Department of Environmental Quality
Office of Land and Water Resources
P.O. Box 10631
Jackson, MS 39229-0631
(601)961-5210
(601)354-6954 (fax)

County: Marshall
 Permit #: 0-162
 Driller: Larry Carpenter
 Date completed: 5-28-07
 (See information from block on Part 1)

For Office Use Only:

Aggr#: F158
 Well #: B-67
 Elevation: _____

This part of the report must be completed by a licensed water well contractor or a licensed pump installer. A copy of Part 1 of the report must be attached and both parts filed with the Department at the above address within 30 days of well completion.

Well Owner Information	Well Location
Owner Name: <u>Southern Home</u>	Latitude: _____ Longitude: _____
Mailing Address: <u>P.O. Box 5172</u>	Method of Lat/Long (check one): <input checked="" type="checkbox"/> Conventional Survey _____
<u>Holly Springs</u> <u>MS</u> <u>38654</u>	UBOS quad _____ Hand-held GPS _____ Survey-grade GPS _____
City State Zip Code	_____ & Sec. <u>10</u> T. <u>15</u> R. <u>3 W</u>
Telephone No. <u>(662) 252-3497</u>	Distance _____ Direction _____ Nearest Town _____
	<u>1 1/2</u> Miles <u>South</u> of <u>Fate Pleasant</u>

Pump Type Circle one	Power Type Circle one
Air Lift <input type="checkbox"/> Jet <input checked="" type="checkbox"/> <u>Submersible</u>	Diesel Engine <input type="checkbox"/> Gasoline Engine <input type="checkbox"/> Natural Gas <input type="checkbox"/>
Bucket <input type="checkbox"/> Piston <input type="checkbox"/> Turbine <input type="checkbox"/>	<u>Electric Motor</u> <input checked="" type="checkbox"/> Hand <input type="checkbox"/> Tractor PTO <input type="checkbox"/>
Centrifugal <input type="checkbox"/> Rotary <input type="checkbox"/> Flowing Well <input type="checkbox"/>	Windmill <input type="checkbox"/> Other (specify): _____
Other (specify): _____	Horse Power Rating of Motor: <u>3/4</u>
Date Pump Installed: <u>5-28-07</u>	Setting Depth: <u>100</u> feet
Rated Pump Capacity: <u>10</u> Gallons Per Minute	Number of Stages: <u>11</u>

Pump Test Data	Method of Measuring Water Level Circle one
Date Well Tested: _____	Air Line <input type="checkbox"/> Electric Measuring Line <input type="checkbox"/> <u>Steel Tape</u> <input checked="" type="checkbox"/>
Static Water Level (A): <u>80</u> Feet Below Land Surface	Other (specify): _____
Pumping Water Level (B): <u>85</u> Feet Below Land Surface	For flowing well, measured shut in head: _____ feet
Drawdown [(B)-(A)]: <u>5</u> Feet Below Land Surface	Well yielded <u>16</u> GPM with a drawdown of _____
Test Pumping Rate: <u>16</u> Gallons Per Minute	<u>5</u> feet after <u>4</u> hours of pumping
Duration of Pump Test (minimum 4 hours): <u>4</u> hours	

I HEREBY CERTIFY that the above statements are true to the best of my knowledge.

LARRY CARPENTER 0-162 Larry Carpenter
 Print Name of Pump Installer and License No. (if applicable) Signature of Pump Installer


Form OLWR-SWR-1B

B-67

The sketch below only intended for water wells.


Description of formations encountered must be provided for all wells and formations unless specifically excluded by regulation.

If well intersects other depths on sketch:
Ground Level _____

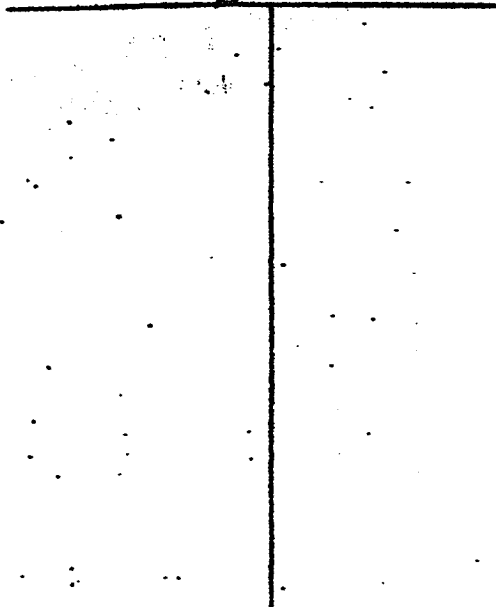

Description of Formations Encountered	From (depth) Ground Level	To (depth)
Surface Soil	0	18
Med. Red Soil	18	42
Med. White Soil	42	80
White Clay	80	98
Fine White Soil	98	110
White Coarse Soil	110	140

If more than one screen, show location of each on sketch

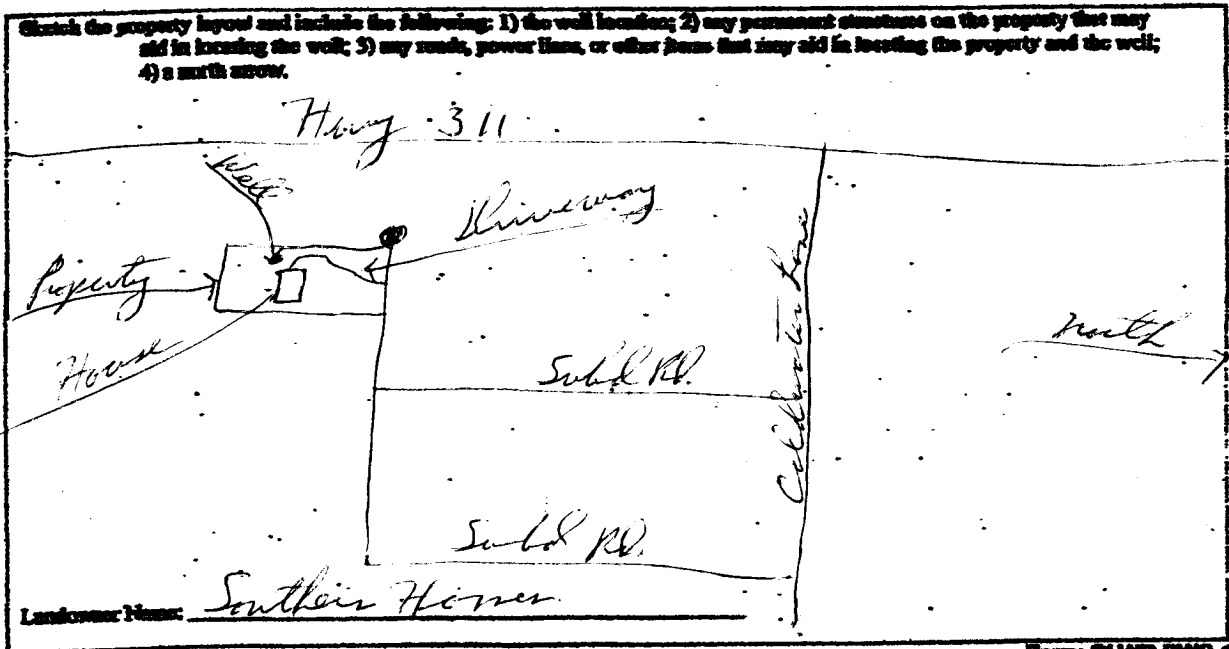

Form: OLWR-SWR-1A

I certify that the well/catchbasin was drilled, constructed, and completed in accordance with all applicable requirements of the Mississippi Department of Environmental Quality and the Mississippi Department of Health regulations, if applicable, and state laws.

Print Name of Responsible Licensee and License No. LARRY CARPENTER 0-162 5-29-07

Signature of Licensee Larry Carpenter

Date

Signature of Licensee