

STATE WELL REPORT

Part 1

Driller's Log

Mississippi Department of Environmental Quality
Office of Land and Water Resources
P.O. Box 2309
Jackson, MS 39225-2309
(601)961-5210
(601)360-0535 (fax)

For Office Use Only:

Well #: F183
Aquifer: _____
E-Log #: _____

County: Marshall
Permit #: GW 17072
Driller: Larry Carpenter
Date drilling completed: 8-17-2013

State Law requires that this report be prepared by the license holder responsible for the work and filed with the Department at the above address within 30 days of completion of drilling of the well or borehole.

Well Owner Information <small>(Landowner if borehole is not for a water well)</small>	Well or Borehole Location
Owner Name: <u>Mark Loftin</u>	Latitude: <u>34° 56' 50" S</u> Longitude: <u>89° 32' 9" W</u>
Mailing Address: <u>30 Loftin Rd</u>	Method of Lat/Long (check one): Conventional Survey _____, USGS quad _____, Hand-held GPS <input checked="" type="checkbox"/> , Survey-grade GPS _____
<u>Red Banks MS 38661</u>	<u>SE 1/4 NE 1/4, Sec 6 T 25 R 3W</u>
City State Zip Code	<u>2</u> Miles <u>SW</u> of <u>Mt Pleasant</u>
Telephone No. <u>(901) 826-3547</u>	(Distance) (Direction) (Nearest Town)

Well / Borehole Data
Date drilling started: <u>8-17-13</u> Date drilling completed: <u>8-17-13</u> Hole depth: <u>290'</u> Hole diameter: <u>12"</u>
Location of the source of any surface water used for drilling: <u>Well Water</u>
Method of dosing and volume of Chlorine used in drilling and development: <u>1 Pt. Chlorine to 1000 Gal. Water</u>
Logs run (circle all applicable): <input checked="" type="checkbox"/> No log run <input type="checkbox"/> Electric <input type="checkbox"/> Gamma Ray <input type="checkbox"/> Density <input type="checkbox"/> Sonic <input type="checkbox"/> Neutron Other: _____
Name of organization running log(s): _____
Purpose of borehole (circle one): Water Well <input type="checkbox"/> Geotechnical/Geological Investigation <input type="checkbox"/> Ground Source Heat Pump <input type="checkbox"/> Seismic Survey <input type="checkbox"/> Other (describe) <u>Agriculture Irrigation</u>
<i>If drilling is not related to water well construction, skip the remainder of this block</i>
Purpose of Well (circle all applicable): Home <input type="checkbox"/> Industrial <input type="checkbox"/> Public Supply <input type="checkbox"/> <input checked="" type="checkbox"/> Irrigation <input type="checkbox"/> Fish Culture
Other (describe): _____
If a flowing well, method of flow regulation: Valve _____ Other (describe) _____
Static Water Level: <u>21</u> feet [above or <input checked="" type="checkbox"/> below] land surface Date measured: <u>8-18-13</u>
Method of measurement (circle one) <input checked="" type="checkbox"/> Steel tape <input type="checkbox"/> Electric tape <input type="checkbox"/> Air line Other (describe): _____
Well depth: <u>290'</u> Well grouted to a depth of: <u>10'</u> feet Type of grout (circle one) <input checked="" type="checkbox"/> Neat Cement <input type="checkbox"/> Bentonite <input type="checkbox"/> Mix
Casing length: <u>230</u> feet Casing diameter: <u>8</u> inches Type of casing: <u>PVC</u>
Screen length: <u>60</u> feet Screen diameter: <u>8</u> inches Type of screen: <u>PVC</u>
Screen slot size: <u>.020</u> inches Setting depth: From <u>230</u> feet to <u>290</u> feet
Type of completion (circle all applicable): <input checked="" type="checkbox"/> Gravel packed <input type="checkbox"/> Underreamed <input type="checkbox"/> Open hole <input type="checkbox"/> Natural Development
Other (describe): _____
Top of lap pipe or reduction in casing: _____ feet
<i>If telescoped or more than one screen, describe on next page</i>

RECEIVED
SEP 17 2013
BY: OLWR
Form: OLWR-SWR-1A (4/13)

STATE WELL REPORT

Part 2

Pump Installer's Completion Report
 Mississippi Department of Environmental Quality
 Office of Land and Water Resources
 P.O. Box 2309
 Jackson, MS 39225-2309
 (601)961-5210
 (601) 360-0535 (fax)

County: Marshall
 Permit #: 0162
 Driller: Larry Carpenter
 Date completed: 8-21-2013
Copy information from block on Part 1

For Office Use Only:

Well #: F183
 Aquifer: _____

This part of the report must be completed by a licensed water well contractor or a licensed pump installer. A copy of Part 1 of the report must be attached and both parts filed with the Department at the above address within 30 days of well completion.

Well Owner Information	Well Location
Owner Name: <u>Marb Loftin</u>	Latitude: <u>34°56.523</u> Longitude: <u>89°32.934</u>
Mailing Address: <u>30 Loftin Rd</u>	Method of Lat/Long (check one): Conventional Survey _____, USGS quad _____, Hand-held GPS <input checked="" type="checkbox"/> , Survey-grade GPS _____
<u>Bed Banks</u> MS <u>38661</u>	_____ 1/4 _____ 1/4, Sec <u>6</u> T <u>25</u> R <u>3W</u>
City State Zip Code	<u>2</u> Miles <u>SW</u> of <u>Mt Pleasant</u>
Telephone No. (<u>901</u>) <u>826-3547</u>	(Distance) (Direction) (Nearest Town)

Pump Type (circle one)

Submersible Turbine Air Lift Centrifugal Flowing Well Jet Piston Rotary Other (describe): _____

Date Pump Installed: 8-20-13 Rated Pump Capacity: 275 Gallons Per Minute

Is This Pump (circle one): New Repaired Replacement

Power Type (circle one)

Electric Diesel Gasoline Natural Gas Tractor PTO Windmill Other (describe): _____

Horse Power Rating of Motor: 25 Setting Depth: 105 feet Number of Stages: 6

Pump Test Data for Non Flowing Well

Date Well Tested: 8-21-13 Duration of Pump Test (minimum 4 hours): 8 hours

Static Water Level (A): 21 Feet Below Land Surface Pumping Water Level (B): 50 Feet Below Land Surface

Drawdown [(B) - (A)]: 29 Feet Below Land Surface Test Pumping Rate: 400 Gallons Per Minute

Method of measurement (circle one): Steel tape Electric tape Air line Other (describe): _____

Pump Test Data for Flowing Well

Measured shut in head: _____ feet.

Well yielded _____ GPM with a drawdown of _____ feet after _____ hours of pumping

Meter Installation

Meter Manufacturer: McCrometer Meter Serial Number: 13-07921

Meter Model Number/Name: M0304 McCrometer Meter Type of Meter: Propeller Flowmeter

Totalizer Register Unit and Multiplier Factor (AF x .001, gal x 1000, etc): Gal. x 100

Installation Date: 9-10-13 Meter installed by: Larry Carpenter Well Co.

Is This Meter (circle one): New Repaired Replacement

RECEIVED
SEP 17 2013

Important: By submitting the above information you are certifying that this meter was installed to manufacturer standards. For agricultural wells, a list of approved meters is on the MDEQ website.

I HEREBY CERTIFY that the above statements are true to the best of my knowledge.


Larry Carpenter #0162 9-11-13 Larry Carpenter
 Print Name/of Pump Installer and License No. (if applicable) Date Signature of Pump Installer

County: marshall
 Permit #: 0162

For Office Use Only:
 Well #: F183

The sketch below only required for water wells
If well telescopes, show depths on sketch.

Description of formations encountered must be provided for all wells and boreholes, unless specifically exempted by regulations

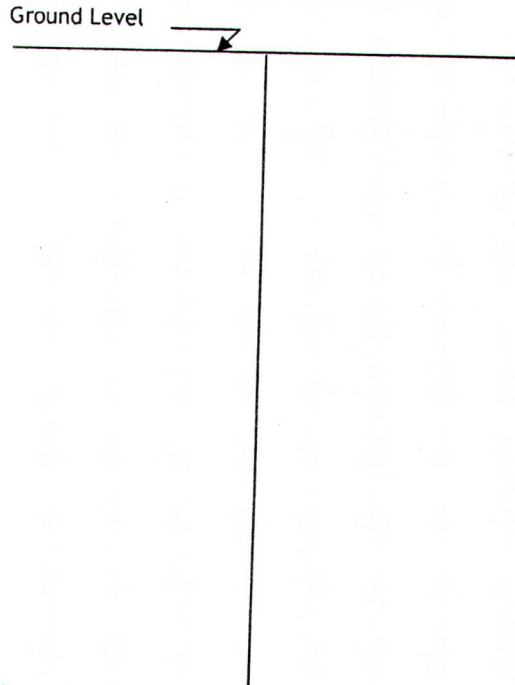


Description of Formations Encountered	From (depth)	To (depth)
Surface Soil	Ground level	15
red Brown Sand	15	45
red. White Sand	45	145
white clay	145	160
Blue clay	160 -	200
red. White Sand	200	220
White Coarse Sand	220	290

If more than one screen, show location of each on sketch

Sketch the property layout and include the following:

- 1) the well location
- 2) any permanent structures on the property that may aid in locating the well
- 3) any roads, power lines, or other items that may aid in locating the property and the well
- 4) north arrow

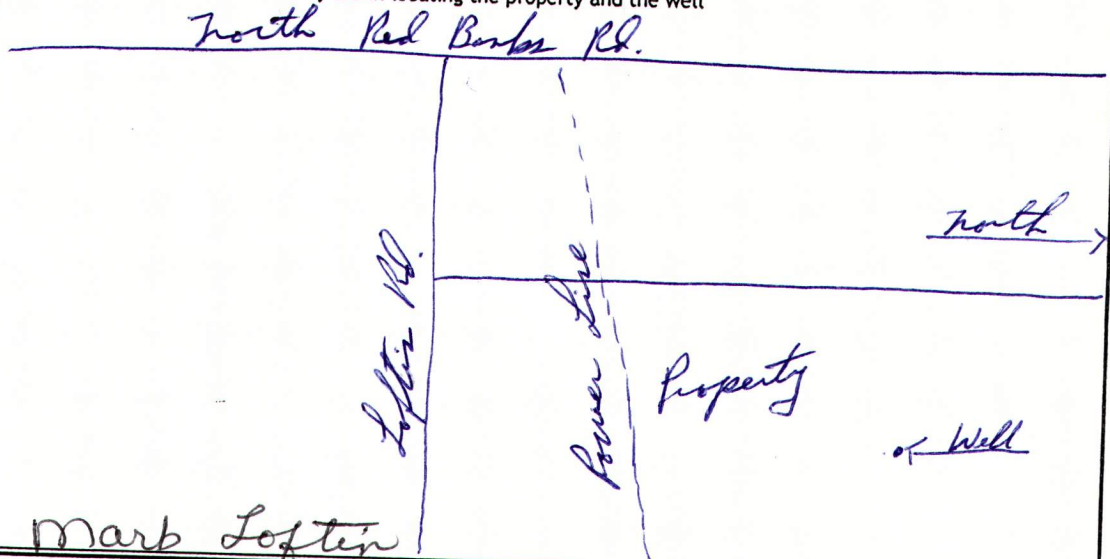

Landowner Name: Marb Loftin

I HEREBY CERTIFY that the well/borehole was drilled, constructed, and completed in accordance with all applicable requirements of the Mississippi Department of Environmental Quality and the Mississippi Department of Health regulations, if applicable, and state laws.

Larry Carpenter #0162 9-11-13 Larry Carpenter
 Print Name of Responsible Licensee and License No. Date Signature of Licensee

Form: OLWR-SWR-1A (4/13)

RECEIVED

SEP 17 2013

BY: OLWR