

Marshall
F 2000
7-1-75

MISSISSIPPI
 BOARD OF WATER COMMISSIONERS
 416 North State Street
 Jackson, Mississippi 39201

15E

WATER WELL DRILLERS LOG


7-1- 1975 W.A. Mason Water Well Contractor Marshall
 date well completed firm name county well located

LANDOWNER:	description of formations encountered	from	to
<u>Vaughn Const. Co.</u>	<u>Clay Silt</u>	<u>00</u>	<u>4</u>
<u>Mt. Pleasant Miss.</u> (mailing address)	<u>Red clay</u>	<u>4</u>	<u>20</u>
WELL LOCATION:	<u>red gravel</u>	<u>20</u>	<u>25</u>
sec. <u>9</u> T <u>2</u> N R <u>3</u> E <u>5</u> <u>W</u>	<u>white clay</u>	<u>25</u>	<u>40</u>
<u>2 1/2</u> miles <u>South</u> of <u>Mt. Pleasant</u> (distance) (direction) (nearest town)	<u>white sand</u>	<u>40</u>	<u>167</u>
WELL PURPOSE: <u>Home</u> (home, irrigation, municipal, industrial)			
WELL COMPLETION DATA:			
(1) diameter (inches) <u>4"</u>			
(2) total depth (feet) <u>167'</u>			
(3) static water level (feet) <u>88</u> below top of ground.			
(4) casing <u>Plastic</u> , <u>157'</u> (material) (depth) <u>4"</u> (size) if telescope see back.			
(5) screen <u>10'</u> , <u>157'</u> (length) (depth to top) <u>4"</u> , <u>Plastic</u> (size) (material)			
(6) pump <u>3/4</u> , <u>10</u> (HP) (yield gpm) <u>electric</u> (type power)			
(7) electric log <u>NO</u> (yes or no) (organization running log)			
(8) how well bottom plugged <u>cap on screen</u>			
DRILLERS REMARKS:			

RECORDED
 FEB 17 1976
 MISS. BD. OF WATER COMMISSIONERS

If well telescopes please sketch and show depths.

GROUND LEVEL

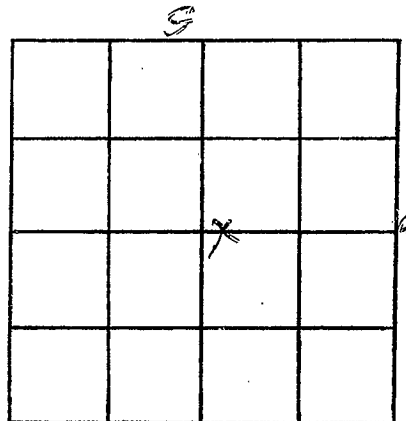

SECTION 9

Please indicate well location X.

ADDITIONAL INFORMATION

If more than one screen, show locations of each on sketch.