

**MARSHALL**  
**F 2003**  
**11-14-75**

**MISSISSIPPI**  
**BOARD OF WATER COMMISSIONERS**  
 416 North State Street  
 Jackson, Mississippi 39201

15E

**WATER WELL DRILLERS LOG**

Nov. 14 1975 R. L. Carpenter Marshall  
 date well completed firm name county well located

LANDOWNER: Wayne Hulle  
Holly Springs  
Miss. RFD  
 (mailing address)


description of formations encountered	from	to
<u>surface soil</u>	<u>0</u>	<u>23</u>
<u>red red sand</u>	<u>23</u>	<u>40</u>
<u>white fine sand</u>	<u>40</u>	<u>65</u>
<u>white clay</u>	<u>65</u>	<u>91</u>
<u>red white sand</u>	<u>91</u>	<u>120</u>
<u>white coarse sand</u>	<u>120</u>	<u>145</u>

WELL LOCATION:  
 sec. 36 T 2 N R 3 E  
6 miles north of Holly Springs  
 (distance) (direction) (nearest town)

WELL PURPOSE: None  
 (home, irrigation, municipal, industrial)

- WELL COMPLETION DATA:
- (1) diameter (inches) 4
  - (2) total depth (feet) 145
  - (3) static water level (feet) 68 below above top of ground.
  - (4) casing Plastic, 139 ft  
 (material) (depth)  
 \_\_\_\_\_ if telescope see back.  
 (size)
  - (5) screen 6 ft, 139 ft  
 (length) (depth to top)  
1/2 in., Plastic + Sand  
 (size) (material)
  - (6) pump 1/2 8  
 (HP) (yield gpm)  
Elec.  
 (type power)
  - (7) electric log no  
 (yes or no)  
 \_\_\_\_\_  
 (organization running log)
  - (8) how well bottom plugged Plastic cap

DRILLERS REMARKS:

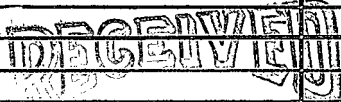

MAR 2 1976

If well telescopes please sketch and show depths.

GROUND LEVEL

		X	

SECTION 36

Please indicate well location X.

ADDITIONAL INFORMATION

If more than one screen,  
show locations of each on sketch.