

**MARSHALL**  
**F 2005**  
**3-1-76**

MISSISSIPPI  
 BOARD OF WATER COMMISSIONERS  
 416 North State Street  
 Jackson, Mississippi 39201

WATER WELL DRILLERS LOG

*March 1* 19 *1976* *W. L. Carpenter* *Marshall*  
 date well completed firm name county well located

LANDOWNER: *David Lee*  
*Holly Springs,*  
*Miss. R.F.D.*  
 (mailing address)


WELL LOCATION:  
 sec. 2 T. 2 N. R. 3 E.  
*1 1/2* miles *Southeast* of *Mt. Pleasant*  
 (distance) (direction) (nearest town)

WELL PURPOSE: *Home*  
 (home, irrigation, municipal, industrial)

- WELL COMPLETION DATA:
- (1) diameter (inches) ~~4~~ 4
  - (2) total depth (feet) ~~147~~ 147
  - (3) static water level (feet) 85 below above top of ground.
  - (4) casing Plastic, 141'  
 (material) (depth)  
 \_\_\_\_\_ if telescope see back.  
 (size)
  - (5) screen 6', 141'  
 (length) (depth to top)  
4 in., Plastic & Iron  
 (size) (material)
  - (6) pump 3/4, 18  
 (HP) (yield gpm)  
9 hp.  
 (type power)
  - (7) electric log No  
 (yes or no)
  - \_\_\_\_\_ (organization running log)
  - (8) how well bottom plugged Plastic cap

description of formations encountered	from	to
<i>Surface Soil</i>	<i>0</i>	<i>15</i>
<i>Med. Red Sand</i>	<i>15</i>	<i>40</i>
<i>white Fine Sand</i>	<i>40</i>	<i>65</i>
<i>White Clay</i>	<i>65</i>	<i>98</i>
<i>Med. White Sand</i>	<i>98</i>	<i>110</i>
<i>White Coarse Sand</i>	<i>110</i>	<i>147</i>


DRILLERS REMARKS:

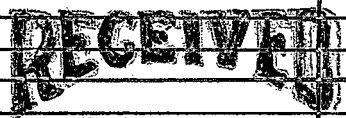

FEB 10 1977

If well telescopes please sketch and show depths.

GROUND LEVEL

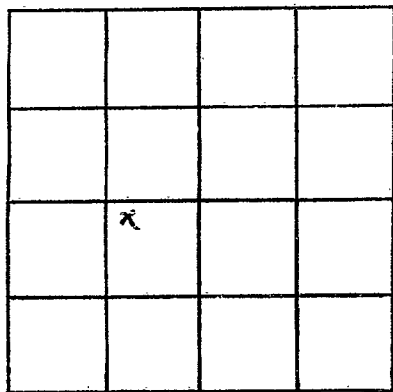

SECTION 2

Please indicate well location X.

ADDITIONAL INFORMATION

If more than one screen,  
show locations of each on sketch.