

MARSHALL
F 2007
3-15-76

MISSISSIPPI
 BOARD OF WATER COMMISSIONERS
 416 North State Street
 Jackson, Mississippi 39201

WATER WELL DRILLERS LOG

3-15 1976 Dean Kent Surfs well Marshall
 date well completed firm name county well located

LANDOWNER:
Granville Cothren
 Rt 2, Healy Springs, Miss
 (mailing address)

WELL LOCATION:
 sec. 15 T. 2 N. R. 3 E.
13 miles North of Healy Springs
 (distance) (direction) (nearest town)

WELL PURPOSE: Drinking
 (home, irrigation, municipal, industrial)

WELL COMPLETION DATA:

(1) diameter (inches) 4"

(2) total depth (feet) 160 feet

(3) static water level (feet) 110 below above top of ground.

(4) casing PVC, 160 feet
 (material) (depth)

 if telescope see back.
 (size)

(5) screen 24T, 153 feet
 (length) (depth to top)

4", gravel wall
 (size) (material)

(6) pump 3/4, 14
 (HP) (yield gpm)

 (type power)

(7) electric log Elect.
 (yes or no)

 (organization running log)

(8) how well bottom plugged H' cap


description of formations encountered	from	to
<u>clay</u>	<u>0</u>	<u>20</u>
<u>sand</u>	<u>20</u>	<u>70</u>
<u>clay</u>	<u>70</u>	<u>75</u>
<u>sand</u>	<u>75</u>	<u>160</u>

DRILLERS REMARKS:

REGISTERED
MISSISSIPPI
APR 14 1976
MISS. Bd. of WATER COMMISSIONERS

If well telescopes please sketch and show depths.

GROUND LEVEL

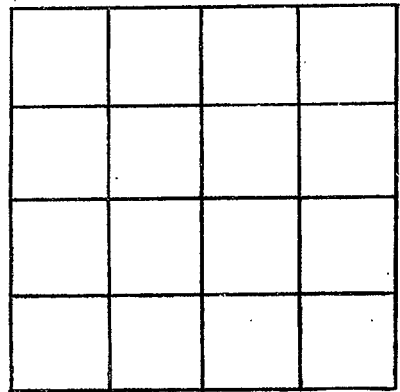

SECTION _____

Please indicate well location X.

ADDITIONAL INFORMATION

If more than one screen, show locations of each on sketch.