

Marshall  
F 2009  
4-28-77

MISSISSIPPI  
 BOARD OF WATER COMMISSIONERS  
 416 North State Street  
 Jackson, Mississippi 39201

WATER WELL DRILLERS LOG

4-28 1977 Dean Water Co. Marshall  
 date well completed firm name county well located

LANDOWNER:  
Sim Hughes  
Pt 2 Holly Springs, Miss  
 (mailing address)

description of formations encountered	from	to
	<u>Clay</u>	<u>0</u>

WELL LOCATION:  
 sec 13 T 2 N R 3 E  
12 miles N of Holly Springs  
 (distance) (direction) (nearest town)

<u>Sand</u>	<u>40</u>	<u>150</u>
-------------	-----------	------------

WELL PURPOSE: Drilling  
 (home, irrigation, municipal, industrial)


WELL COMPLETION DATA:  
 (1) diameter (inches) 4"  
 (2) total depth (feet) 150 feet  
 (3) static water level (feet) 105 below top of ground.  
 (4) casing PVC, 150 feet  
 (material) (depth)  
 (size) If telescope see back.  
 (5) screen 7 feet, 143 feet  
 (length) (depth to top)  
4" Gravel wall  
 (size) (material)  
 (6) pump 3/4 14  
 (HP) (yield gpm)  
 (type power)  
 (7) electric log clot.  
 (yes or no)  
 (organization running log)  
 (8) how well bottom plugged 4" of

**RECEIVED**  
 MAY 10 1977  
 MISS. BD. OF WATER COMMISSIONERS

DRILLERS REMARKS:

If well telescopes please sketch and show depths.

GROUND LEVEL

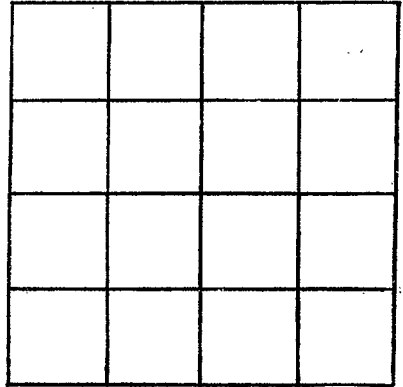

SECTION \_\_\_\_\_

Please indicate well location X.

ADDITIONAL INFORMATION

If more than one screen, show locations of each on sketch.