

MARSHALL  
 F 2010  
 7-5-77

MISSISSIPPI  
 BOARD OF WATER COMMISSIONERS  
 416 North State Street  
 Jackson, Mississippi 39201

WATER WELL DRILLERS LOG

July 5 1977 Demetrius Campbell Marshall  
 date well completed firm name county well located

LANDOWNER:  
Howard Owens  
Red Banks  
 (mailing address)

description of formations encountered	from	to
Clay	0	20
Soil	20	120

WELL LOCATION:  
 sec. 17 T. 2 N. R. 3 E.  
5 miles South of Walden  
 (distance) (direction) (nearest town)

WELL PURPOSE: Dwelling  
 (home, irrigation, municipal, industrial)


- WELL COMPLETION DATA:
- (1) diameter (inches) 4"
  - (2) total depth (feet) 120 feet
  - (3) static water level (feet) 43 below above top of ground.
  - (4) casing PVC, 120 feet  
 (material) (depth)  
 (size) if telescope see back.
  - (5) screen 7 ft, 113 feet  
 (length) (depth to top)  
4", Gravel waf  
 (size) (material)
  - (6) pump 1 Horse, 20  
 (HP) (yield gpm)  
 (type power)
  - (7) electric log elect.  
 (yes or no)  
 (organization running log)
  - (8) how well bottom plugged 4" cof

**RECEIVED**  
 AUG 17 1977

DRILLERS REMARKS:

If well telescopes please sketch and show depths.

GROUND LEVEL

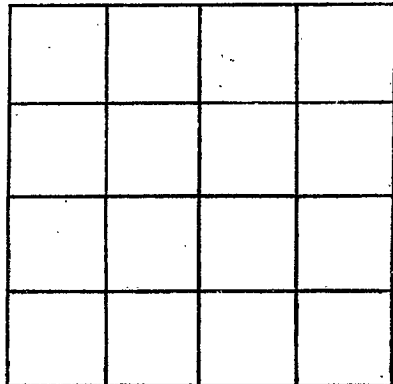

SECTION \_\_\_\_\_

Please indicate well location X.

ADDITIONAL INFORMATION

If more than one screen, show locations of each on sketch.