

Marshall
 F 2011
 10/28/77

MISSISSIPPI
 BOARD OF WATER COMMISSIONERS
 416 North State Street
 Jackson, Mississippi 39201

WATER WELL DRILLERS LOG

10-28 date well completed
 1977 Pemphig Springs well firm name
 Marshall county well located

LANDOWNER:
 Crawville Colburn
 at 2. Halls Springs
 (mailing address)

description of formations encountered	from	to
clay	0	20
sand	20	168

WELL LOCATION:
 sec 15 T 2 N R 3 E
 13 miles North of Halls Springs
 (distance) (direction) (nearest town)

WELL PURPOSE: private
 (home, irrigation, municipal, industrial)

- WELL COMPLETION DATA:
- (1) diameter (inches) 4"
 - (2) total depth (feet) 168 feet
 - (3) static water level (feet) 115 below top of ground.
 - (4) casing pvc 168 feet
 (material) (depth)
 - (size) if telescope see back.
 - (5) screen 7ft. 16 feet
 (length) (depth to top)
 - 4" 2 inch wall
 (size) (material)
 - (6) pump 3/4 14
 (HP) (yield/gpm)
 - (type power)
 - (7) electric log elef.
 (yes or no)
 - (organization running log)
 - (8) how well bottom plugged 4" of


DEGENWITZ
 NOV - 4 1977

DRILLERS REMARKS:

MISS. BD. OF WATER COMMISSIONERS

If well telescopes please sketch and show depths.

GROUND LEVEL

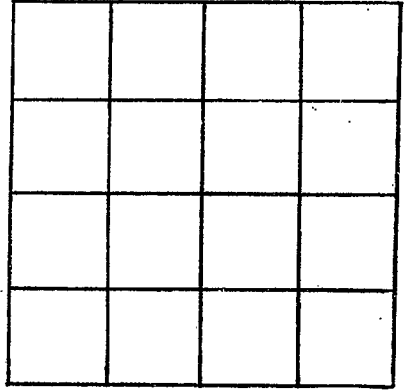

SECTION _____

Please indicate well location X.

ADDITIONAL INFORMATION

If more than one screen,
show locations of each on sketch.