

MARSHALL

F 2013

5-24-78

MISSISSIPPI BOARD OF WATER COMMISSIONERS
416 North State Street
Jackson, Mississippi 39201

WATER WELL DRILLERS LOG

5-24-1978 Deuffhard Construction Marshall
date well completed firm name county well located

LANDOWNER:

Alice Benjamin
Holly Springs, Miss.
(mailing address)

description of formations encountered

from to

clay 0 140
sand 140 210

WELL LOCATION:

sec. 15 T 2 N R. 3 E
3 miles South of Mill Pleasant
(distance) (direction) (nearest town)

WELL PURPOSE: water
(home, irrigation, municipal, industrial)

WELL COMPLETION DATA:

- (1) diameter (inches) 4"
- (2) total depth (feet) 210 feet
- (3) static water level (feet) 155 ft below above top of ground.
- (4) casing PVC 210
(material) (depth)
(size) If telescope see back.
- (5) screen 7 ft. 203 feet
(length) (depth to top)
4" gravel wall
(size) (material)
- (6) pump 3/4 14
(HP) (yield gpm)
(type power)
- (7) electric log clad.
(yes or no)
(organization running log)
- (8) how well bottom plugged 4" cap.

DRILLERS REMARKS:


RECEIVED

JUN - 9 1978

MISS. BD. OF WATER COMM

If well telescopes please sketch and show depths.

GROUND LEVEL

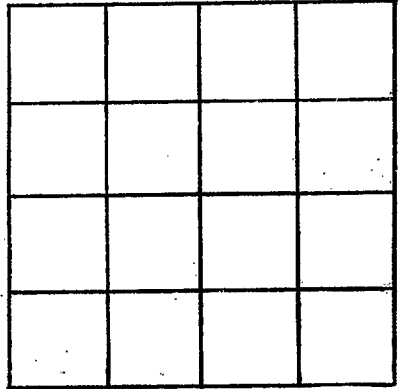

SECTION _____

Please indicate well location X.

ADDITIONAL INFORMATION

If more than one screen, show locations of each on sketch.