

MARSHALL

F 215

10-23-78

MISSISSIPPI BOARD OF WATER COMMISSIONERS
416 North State Street
Jackson, Mississippi 39201

WATER WELL DRILLERS LOG

10-23-78 date well completed
28 Pearl Street Gulf Breeze, Marshall firm name
Marshall county well located

LANDOWNER:

Don Grinnett

description of formations encountered

from to

clay

0 20

Art. Pleasant, Miss.
(mailing address)

sand

20 100

WELL LOCATION:

sec. 3 T 2 N R 3 E
2 miles South of Pleasant
(distance) (direction) (nearest town)

clay

100 110

sand

110 180

WELL PURPOSE: Drilling
(home, irrigation, municipal, industrial)

WELL COMPLETION DATA:

- (1) diameter (inches) 4"
- (2) total depth (feet) 180 feet
- (3) static water level (feet) 100 below top of ground.

- (4) casing PVC 180 feet
(material) (depth)

(size) If telescope see back.

- (5) screen 7 ft. 173 feet
(length) (depth to top)

4" gravel wall
(size) (material)

- (6) pump 3/4 14
(HP) (yield gpm)


(type power)

- (7) electric log flat.
(yes or no)

(organization running log)

- (8) how well bottom plugged 4' cap.

DRILLERS REMARKS:

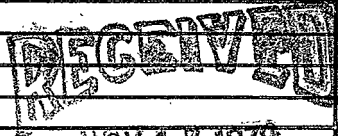


NOV 17 1978

MISS. BD. OF WATER COMM.

If well telescopes please sketch and show depths.

GROUND LEVEL

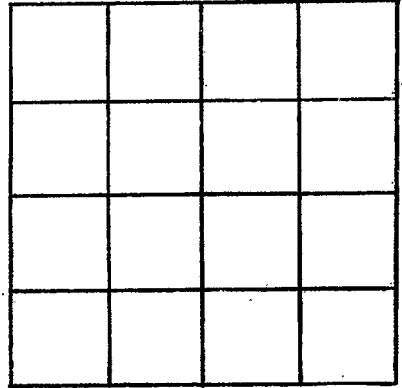

SECTION _____

Please indicate well location X.

ADDITIONAL INFORMATION

If more than one screen, show locations of each on sketch.