

MARSHALL

F 2016

4-3-78

April 3 1978
date well completed

MISSISSIPPI
BOARD OF WATER COMMISSIONERS
416 North State Street
Jackson, Mississippi 39201

WATER WELL DRILLERS LOG

R. L. Carpenter Marshall
firm name county well located

LANDOWNER: Bill Provine

Potts Camp, Miss.

(mailing address)

WELL LOCATION:

sec. 35 T-2 N R-3 E
6 miles North of Holly Springs
(distance) (direction) (nearest town)

WELL PURPOSE: Agricultural
(home, irrigation, municipal, industrial)

WELL COMPLETION DATA:

- (1) diameter (inches) 4
- (2) total depth (feet) 140
- (3) static water level (feet) 3 below above top of ground.
- (4) casing Plastic, 100'
(material) (depth)
- (size) if telescope see back.
- (5) screen 18', 108'
(length) (depth to top)
- 4", Plastic
(size) (material)
- (6) pump 1/2, 10
(HP) (yield gpm)
- Elec.
(type power)
- (7) electric log No.
(yes or no)

(organization running log)

(8) how well bottom plugged PVC cap

DRILLERS REMARKS:

description of formations encountered

from

to

Surface Soil

0

25

White Fine Sand & Clay

25

60

White Clay

60

78

White Coarse Sand

78

110


DEPT. OF NATURAL RESOURCES
BUREAU OF LAND & WATER RESOURCES

JUL 28 1978

RECEIVED

If well telescopes please sketch and show depths.

GROUND LEVEL

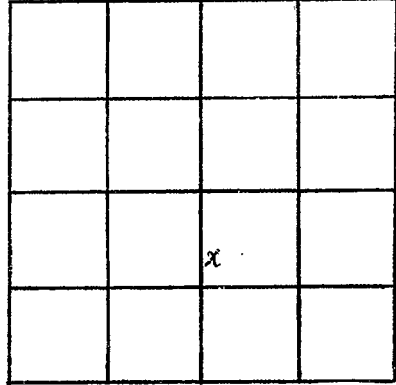

SECTION 35

Please indicate well location X.

ADDITIONAL INFORMATION

If more than one screen,
show locations of each on sketch.