

MARSHALL

F 2017

8-11-78

MISSISSIPPI BOARD OF WATER COMMISSIONERS  
416 North State Street  
Jackson, Mississippi 39201

WATER WELL DRILLERS LOG

8-11-1978 date well completed  
28 P... firm name  
Marshall county well located

LANDOWNER:

J. T. Jones  
Hardsburg, Miss.  
(mailing address)

description of formations encountered

from to

Clay 0 10  
Sand 10 140

WELL LOCATION:

sect T 2 N R 3 E  
12 miles NORTH of H.S.  
(distance) (direction) (nearest town)

WELL PURPOSE  
(home, irrigation, municipal, industrial)

WELL COMPLETION DATA:


- (1) diameter (inches) 4"
- (2) total depth (feet) 140 feet
- (3) static water level (feet) 105 below top of ground.
- (4) casing PVC 140 feet (material) (depth)
- (size) If telescope see back.
- (5) screen 7 ft. 133 feet (length) (depth to top)
- 1/2" gravel wrap (size) (material)
- (6) pump 3/4 HP 14 (yield gpm)
- (type power)
- (7) electric log 3 feet (yes or no)
- (organization running log)
- (8) how well bottom plugged 4" cap

DRILLERS REMARKS:

RECEIVED  
SEP 14 1978  
MISS. BD. OF WATER COMMISSIONERS

If well telescopes please sketch and show depths.

GROUND LEVEL

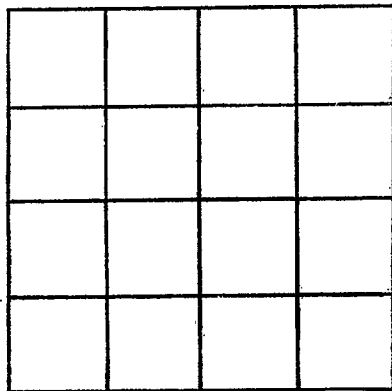

SECTION \_\_\_\_\_

Please indicate well location X.

ADDITIONAL INFORMATION

If more than one screen, show locations of each on sketch.