

MARSHALL  
 F 2018  
 8-24-78

MISSISSIPPI  
 BOARD OF WATER COMMISSIONERS  
 416 North State Street  
 Jackson, Mississippi 39201

WATER WELL DRILLERS LOG

8-24-78 date well completed  
 1978 Dean Hart Drilling Co. firm name  
 Marshall county well located

LANDOWNER:  
 F. C. Young  
 Holly Springs, Miss.  
 (mailing address)

description of formations encountered	from	to
clay	0	10
gravel	10	130

WELL LOCATION:  
 sec. 26 T. 3 N. R. 3 E.  
 13 miles North of H.S.  
 (distance) (direction) (nearest town)

WELL PURPOSE: Drinking  
 (home, irrigation, municipal, industrial)

- WELL COMPLETION DATA:
- (1) diameter (inches) 4"
  - (2) total depth (feet) 130 feet
  - (3) static water level (feet) 40 below top of ground.
  - (4) casing PVC 130 feet  
 (material) (depth)
  - (size) If telescope see back.
  - (5) screen 24" 133 feet  
 (length) (depth to top)
  - 4" gravel wash  
 (size) (material)
  - (6) pump 3/4 14  
 (HP) (yield gpm)
  - (type power)
  - (7) electric log clay  
 (yes or no)
  - (organization running log)
  - (8) how well bottom plugged 4" cof.


RECEIVED  
 SEP 14 1978

MISS. BD. OF WATER COMMISSIONERS

DRILLERS REMARKS:

If well telescopes please sketch and show depths.

GROUND LEVEL

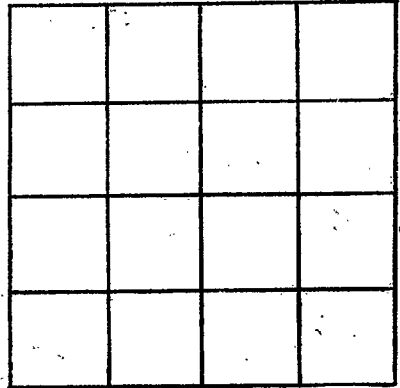

SECTION \_\_\_\_\_

Please indicate well location X.

ADDITIONAL INFORMATION

If more than one screen, show locations of each on sketch.