

MARSHALL

F 2020

10-12-78

MISSISSIPPI
 BOARD OF WATER COMMISSIONERS
 416 North State Street
 Jackson, Mississippi 39201

8

WATER WELL DRILLERS LOG

Oct 12 1978
date well completed

R. L. Carpenter
firm name

Marshall
county well located

LANDOWNER: Clara Shaver
Holly Springs, Miss
RFD
 (mailing address)

description of formations encountered

from to

Surface Soil 0 18

Coarse Red Sand 18 45

White med. sand 45 80

White Clay 80 95

White Coarse Sand 95 128

WELL LOCATION:

sec. 12 T. 2 N. R. 3 E.
 (S) (W)
2 miles SW of Hayden
 (distance) (direction) (nearest town)

WELL PURPOSE: None
 (home, irrigation, municipal, industrial)

WELL COMPLETION DATA:

(1) diameter (inches) 4

(2) total depth (feet) 128

(3) static water level (feet) 90 below above top of ground.

(4) casing Plastic, 118'
(material) (depth)

(size) if telescope see back.

(5) screen 10', 118'
(length) (depth to top)

4", Plastic
(size) (material)

(6) pump 3/4, 12
(HP) (yield gpm)

Elec
(type power)

(7) electric log no
(yes or no)

(organization running log)

(8) how well bottom plugged PVC cap

DEPT. OF NATURAL RESOURCES
BUREAU OF LAND & WATER RESOURCES


APR 30 1981

RECEIVED

DRILLERS REMARKS:

If well telescopes please sketch and show depths.

GROUND LEVEL

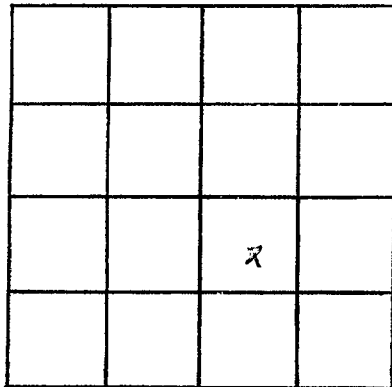

SECTION 12

Please indicate well location X.

ADDITIONAL INFORMATION

A series of horizontal lines for writing additional information, starting below the 'ADDITIONAL INFORMATION' header and extending down to the bottom of the page.

If more than one screen, show locations of each on sketch.