

MARSHALL  
F 2021  
8-19-78

MISSISSIPPI  
BOARD OF WATER COMMISSIONERS  
416 North State Street  
Jackson, Mississippi 39201

WATER WELL DRILLERS LOG

Aug 19 1978 R.L. Carpenter Marshall  
date well completed firm name county well located

LANDOWNER: *Martese Boman*  
*Holly Springs, Miss*  
*RFD*  
(mailing address)

WELL LOCATION:  
sec. ~~23~~ T 2 N R 3 E  
3 1/2 miles SW of *Shogben*  
(distance) (direction) (nearest town)

WELL PURPOSE: *Home*  
(home, irrigation, municipal, industrial)

WELL COMPLETION DATA:

(1) diameter (inches) 4

(2) total depth (feet) 232

(3) static water level (feet) 105 below top of ground.

(4) casing Plastic, 222'  
(material) (depth)

(size) if telescope see back.

(5) screen 10', 222'  
(length) (depth to top)

4", Plaster  
(size) (material)

(6) pump 1/2 9  
(HP) (yield gpm)

Eder  
(type power)

(7) electric log Yes  
(yes or no)

(organization running log)

(8) how well bottom plugged PVC Cap

DRILLERS REMARKS:

description of formations encountered	from	to
surface soil	0	21
med red sand	21	38
med white sand	38	69
white clay & fine sand mixed	69	130
white clay	130	175
med white sand	175	210
white coarse sand	210	232


DEPT. OF NATURAL RESOURCES  
BUREAU OF LAND & WATER RESOURCES

APR 30 1981

RECEIVED

If well telescopes please sketch and show depths.

GROUND LEVEL

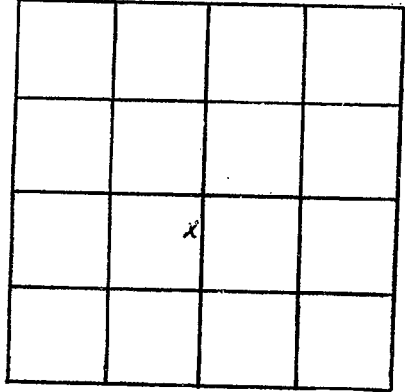

SECTION 23

Please indicate well location X.

ADDITIONAL INFORMATION

If more than one screen, show locations of each on sketch.