

Marshall
F 2022
4/13/79

MISSISSIPPI
BOARD OF WATER COMMISSIONERS
416 North State Street
Jackson, Mississippi 39201

WATER WELL DRILLERS LOG

April 13 19 79 Red Carpenter Marshall
date well completed firm name county well located

LANDOWNER: Willie Langston
Holly Springs, Miss.
R. F. P.
(mailing address)

| description of formations encountered | from | to |
|---------------------------------------|------|-----|
| Surface Soil | 0 | 15 |
| Coarse Red Sand | 15 | 36 |
| Med. White Sand | 36 | 80 |
| White Clay | 80 | 90 |
| White Coarse Sand | 90 | 115 |

WELL LOCATION:
sec. 3 T 2 N R 3 E
S W
2 miles South of Mt. Pleasant
(distance) (direction) (nearest town)

WELL PURPOSE: Home
(home, irrigation, municipal, industrial)

- WELL COMPLETION DATA:
- (1) diameter (inches) 4
 - (2) total depth (feet) 115
 - (3) static water level (feet) 82 below top of ground.
 - (4) casing Plaster, 105' (material) (depth)
(size) if telescope see back.
 - (5) screen 10' length, 105' depth to top
4" Plaster (size) (material)
 - (6) pump 1/2 HP, 10 (yield gpm)
Class (type power)
 - (7) electric log no. (yes or no)
(organization running log)
 - (8) how well bottom plugged P.V.C. cap


DRILLERS REMARKS:

DEPT. OF NATURAL RESOURCES
BUREAU OF LAND & WATER RESOURCES

MAY 18 1981
RECEIVED

If well telescopes please sketch and show depths.

GROUND LEVEL

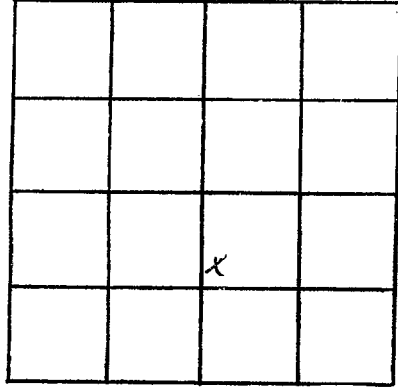

SECTION 3

Please indicate well location X.

ADDITIONAL INFORMATION

If more than one screen, show locations of each on sketch.