

MARSHALL
 F 2027
 04-13-79

MISSISSIPPI
 BOARD OF WATER COMMISSIONERS
 416 North State Street
 Jackson, Mississippi 39201

WATER WELL DRILLERS LOG

4-13 1979 Nichols Well Co. Marshall
 date well completed firm name county well located

LANDOWNER:
 Floyce T. Son Jr.
 Rt. 2 Box 199 Holly Springs
 (mailing address)

WELL LOCATION:
 sec. 23 T 2 N R 3 E
 7 miles North of Holly Springs
 (distance) (direction) (nearest town)

WELL PURPOSE: home
 (home, irrigation, municipal, industrial)

WELL COMPLETION DATA:
 (1) diameter (inches) 4 in
 (2) total depth (feet) 200 ft
 (3) static water level (feet) 160 below top of ground.
 (4) casing Plastic, 200 (material) (depth)
 (size) If telescope see back.
 (5) screen 7 ft, 193 ft (length) (depth to top)
 4 in, gravel (size) (material)
 (6) pump 1/2, 10 (HP) (yield gpm)
 220 (type power)
 (7) electric log No (yes or no)
 (organization running log)
 (8) how well bottom plugged Cap

description of formations encountered	from	to
Red Clay	0	10
Sand	10	90
White Clay + Sand	90	140
White Sand	140	160
Black Clay	160	175
White Sand	175	200

DRILLERS REMARKS:


Miss. Board of Water Comm.

APR 26 1979

RECEIVED

If well telescopes please sketch and show depths.

GROUND LEVEL

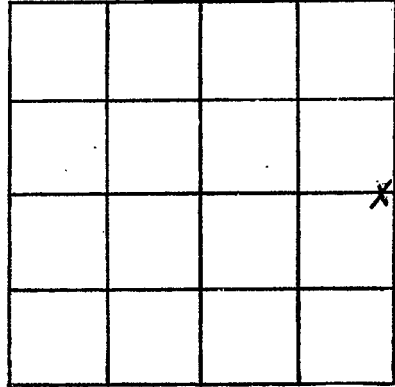

SECTION 23

Please indicate well location X.

ADDITIONAL INFORMATION

If more than one screen, show locations of each on sketch.