

Marshall
 F 2028
 4-16-79

MISSISSIPPI
 BOARD OF WATER COMMISSIONERS
 416 North State Street
 Jackson, Mississippi 39201

WATER WELL DRILLERS LOG

4-16 1979 Dean Sport Buggy wells Marshall
 date well completed firm name county well located

LANDOWNER:	description of formations encountered	from	to
my wife			
Head Springs, miss. (mailing address)	sand	10	100
WELL LOCATION:			
sec <u>22</u> T <u>2</u> N R <u>3</u> E			
<div style="display: flex; justify-content: space-around;"> ③ ④ </div> <u>10</u> miles <u>north</u> of <u>Head Springs</u> (distance) (direction) (nearest town)			
WELL PURPOSE: <u>Drinking</u> (home, irrigation, municipal, industrial)			
WELL COMPLETION DATA:			
(1) diameter (inches) <u>4"</u>			
(2) total depth (feet) <u>100 ft</u>			
(3) static water level (feet) <u>90</u> below top of ground.			
(4) casing <u>PVC</u> , <u>100 ft</u> (material) (depth)			
(size) If telescope see back.			
(5) screen <u>7 ft</u> , <u>9.3 feet</u> (length) (depth to top)			
<u>4"</u> , <u>gravel well</u> (size) (material)			
(6) pump <u>3/4</u> <u>14</u> (HP) (yield gpm)			
(type power)			
(7) electric log <u>Elect</u> (yes or no)			
(organization running log)			
(8) how well bottom plugged <u>4" cap</u>			

Miss. Board of Water Comm.


MAY 21 1979

RECEIVED

DRILLERS REMARKS:

If well telescopes please sketch and show depths.

GROUND LEVEL

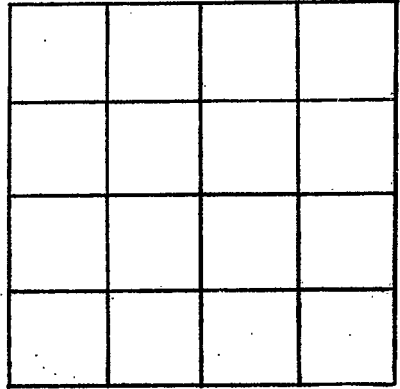

SECTION _____

Please indicate well location X.

ADDITIONAL INFORMATION

If more than one screen, show locations of each on sketch.