

Marshall
F 2030
59-80

MISSISSIPPI
BOARD OF WATER COMMISSIONERS
416 North State Street
Jackson, Mississippi 39201

WATER WELL DRILLERS LOG

5-9-80 date well completed
30 Peapack + Burleson firm name
Marshall county well located

LANDOWNER: Mr. Walker
gnt. Pleasant vna. (mailing address)

description of formations encountered: Clay, Sand

from 0 to 20
20/150

WELL LOCATION:
sec 9 T 2 N R 3 E
4 miles South of Pleasant
(distance) (direction) (nearest town)

WELL PURPOSE: Drinking
(home, irrigation, municipal, industrial)

- WELL COMPLETION DATA:
- (1) diameter (inches) 4"
 - (2) total depth (feet) 150 feet
 - (3) static water level (feet) 10 feet below top of ground.
 - (4) casing PVC (material) 150 feet (depth)
 - (size) If telescope see back.
 - (5) screen 7 ft (length) 143 feet (depth to top)
 - 4" (size) Sandwood (material)
 - (6) pump 3/4 (HP) 14 (yield gpm)
 - (type power)
 - (7) electric log yes (yes or no)
 - (organization running log)
 - (8) how well bottom plugged 4" cap.

DRILLERS REMARKS:


DEPT. OF NATURAL RESOURCES
BUREAU OF LAND & WATER RESOURCES

JUN 18 1980

RECEIVED

If well telescopes please
sketch and show depths.

GROUND LEVEL

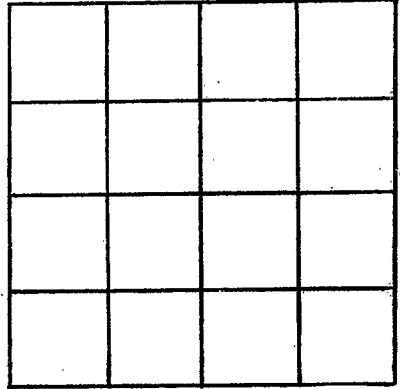

SECTION _____

Please indicate well location X.

ADDITIONAL INFORMATION

If more than one screen,
show locations of each on sketch.