

Marshall
F 2031
3/22/80

MISSISSIPPI
 BOARD OF WATER COMMISSIONERS
 416 North State Street
 Jackson, Mississippi 39201

WATER WELL DRILLERS LOG

Mar. 22 1980 R. L. Carpenter Marshall
 date well completed firm name county well located

LANDOWNER: Walter Durn
Red Banks, Miss
RFD
 (mailing address)

description of formations encountered	from	to
<u>Surface Soil</u>	<u>0</u>	<u>12</u>
<u>Fire Red Soil</u>	<u>12</u>	<u>35</u>
<u>red. white Soil</u>	<u>35</u>	<u>77</u>
<u>white Clay</u>	<u>77</u>	<u>98</u>
<u>white coarse Soil</u>	<u>98</u>	<u>123</u>

WELL LOCATION:
 sec. 18 T. 2 N R. 3 E
S W
3 1/2 miles SW of 2nd Plant
 (distance) (direction) (nearest town)

WELL PURPOSE: None
 (home, irrigation, municipal, industrial)

- WELL COMPLETION DATA:
- (1) diameter (inches) 4
 - (2) total depth (feet) 123
 - (3) static water level (feet) 75 below above top of ground.
 - (4) casing PVC, 123'
 (material) (depth)
 (size) if telescope see back.
 - (5) screen 10', 123'
 (length) (depth to top)
4", PVC
 (size) (material)
 - (6) pump 1/2, 10
 (HP) (yield gpm)
Elec.
 (type power)
 - (7) electric log no
 (yes or no)
 (organization running log)
 - (8) how well bottom plugged PVC Cap


DRILLERS REMARKS:

DEPT. OF NATURAL RESOURCES
 BUREAU OF LAND & WATER RESOURCES

MAY 18 1980
 RECEIVED

If well telescopes please
sketch and show depths.

GROUND LEVEL

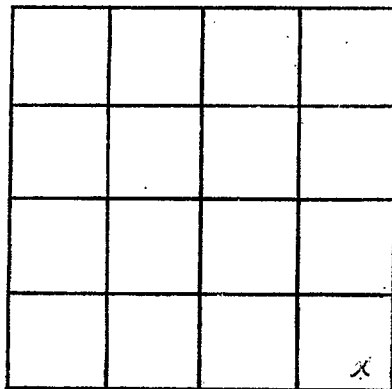

SECTION 18

Please indicate well location X.

ADDITIONAL INFORMATION

If more than one screen,
show locations of each on sketch.