

Marshall
F-2032
8/10/80

MISSISSIPPI
BOARD OF WATER COMMISSIONERS
416 North State Street
Jackson, Mississippi 39201

WATER WELL DRILLERS LOG

Aug. 10 1980 R. L. Carpenter, Marshall
date well completed firm name county well located

LANDOWNER: Joe Loomer
Red Bank, Miss.
RFD
(mailing address)

WELL LOCATION:
sec. 8 T. 2 N R. 3 E
S W
2 1/2 miles SW of Mt. Pleasant
(distance) (direction) (nearest town)

WELL PURPOSE: Home
(home, irrigation, municipal, industrial)

WELL COMPLETION DATA:
(1) diameter (inches) 4
(2) total depth (feet) 145
(3) static water level (feet) 55 below top of ground.
(4) casing PVC, 135'
(material) (depth)
if telescope see back.
(size)
(5) screen 18', 135'
(length) (depth to top)
4" PVC
(size) (material)
(6) pump 1/2 HP, 10
(HP) (yield gpm)
Eber.
(type power)
(7) electric log yes
(yes or no)
(organization running log)
(8) how well bottom plugged PVC cap

description of formations encountered	from	to
Surface Soil	0	14
Med. Red Sand	14	40
Med. White Sand	40	60
White Clay	60	93
White Fine Sand	93	110
White Coarse Sand	110	145

DRILLERS REMARKS:


DEPT. OF NATURAL RESOURCES
BUREAU OF LAND & WATER RESOURCES

MAY 28 1981

RECEIVED

If well telescopes please sketch and show depths.

GROUND LEVEL

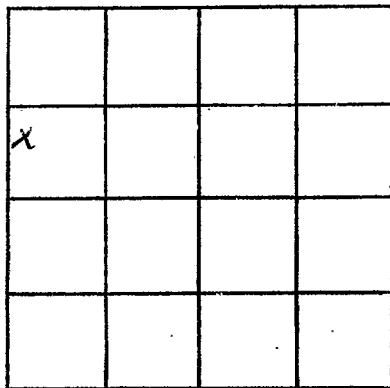

SECTION 8

Please indicate well location X.

ADDITIONAL INFORMATION

If more than one screen,
show locations of each on sketch.