

MARSHALL  
F 2033  
8/21/80

MISSISSIPPI  
BOARD OF WATER COMMISSIONERS  
416 North State Street  
Jackson, Mississippi 39201

WATER WELL DRILLERS LOG

Aug. 21 1980 R. L. Carpenter Marshall  
date well completed firm name county well located

LANDOWNER: Dorrell Woods  
Red Boiling, Miss.  
RFD  
(mailing address)

WELL LOCATION:  
sec. 8 T. 2 N R. 3 E  
S W  
2 miles SW of Not Pleasant  
(distance) (direction) (nearest town)

WELL PURPOSE: Home  
(home, irrigation, municipal, industrial)

WELL COMPLETION DATA:  
(1) diameter (inches) 4  
(2) total depth (feet) 180  
(3) static water level (feet) 120 below top of ground.  
(4) casing PVC 170'  
(material) (depth)  
(size) if telescope see back.  
(5) screen 10' 170'  
(length) (depth to top)  
4 1/2" PVC  
(size) (material)  
(6) pump 3/4 12  
(HP) (yield gpm)  
2 hp.  
(type power)  
(7) electric log no  
(yes or no)  
(organization running log)  
(8) how well bottom plugged PVC cap


description of formations encountered	from	to
Surface Soil	0	20
Coarse Red Sand	20	65
Fine White Sand	65	110
Med. White Sand	110	138
White Clay	138	155
White Coarse Sand	155	180

DRILLERS REMARKS:

DEPT. OF NATURAL RESOURCES  
BUREAU OF LAND & WATER RESOURCES  
MAY 18 1981  
RECEIVED

If well telescopes please sketch and show depths.

GROUND LEVEL

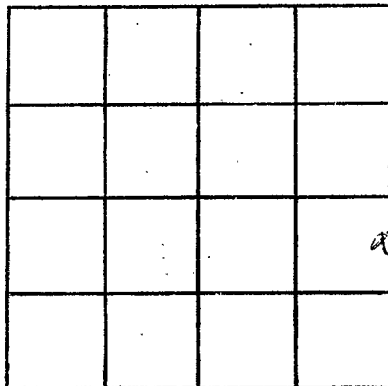

SECTION 8

Please indicate well location X.

ADDITIONAL INFORMATION

If more than one screen, show locations of each on sketch.