

MARSHALL

F 2034

2-23-81

2-23-81 19

MISSISSIPPI DEPARTMENT OF NATURAL RESOURCES  
 Bureau of Land and Water Resources  
 Southport Mall  
 P.O. Box 10631  
 Jackson, Mississippi 39209  
**WATER WELL DRILLERS LOG**

Wilson Wells, Inc Marshall  
 firm name county well located

LANDOWNER: Larry Miller

Rt 2

Mt. Pleasant, MS  
(mailing address)

WELL LOCATION: SE Corner Sec 36

sec. 36 T. 2 N. R. 4-3 E.

5 miles SW of Mt Pleasant  
(distance) (direction) (nearest town)

WELL PURPOSE: home  
(home, irrigation, municipal, industrial)

WELL COMPLETION DATA:

(1) diameter (inches) 4

(2) total depth (feet) 135

(3) static water level (feet) 50 below top of ground.

(4) casing Plastic, 125'  
(material) (depth)

4" if telescope see back.  
(size)

(5) screen 10', 125'  
(length) (depth to top)

4", Plastic  
(size) (material)

(6) pump 1 (HP) 14 (yield gpm)


electric  
(type power)

(7) electric log no  
(yes or no)

(organization running log)

(8) how well bottom plugged Plastic Cap

description of formations encountered	from	to
<u>Red clay - Red Sand</u>	<u>0</u>	<u>30</u>
<u>White clay - White Sand</u>	<u>30</u>	<u>60</u>
<u>White Sand</u>	<u>60</u>	<u>90</u>
<u>White SAND - white clay - white Sand</u>	<u>90</u>	<u>105</u>
<u>White Sand</u>	<u>105</u>	<u>135</u>

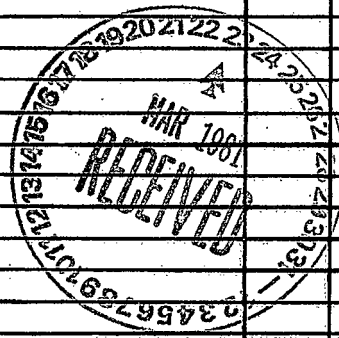

DEPT. OF NATURAL RESOURCES  
BUREAU OF LAND & WATER RESOURCES


MAR 23 1981

RECEIVED

DRILLERS REMARKS:

If well telescopes please sketch and show depths.

GROUND LEVEL

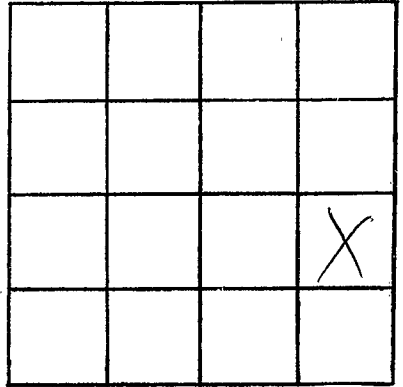

SECTION \_\_\_\_\_

Please indicate well location X.

ADDITIONAL INFORMATION

If more than one screen,  
show locations of each on sketch.