

MISSISSIPPI DEPARTMENT OF NATURAL RESOURCES

Bureau of Land and Water Resources

Southport Mall

P.O. Box 10631

Jackson, Mississippi 39209

WATER WELL DRILLERS LOG

Marshall  
F 2035  
3-24-81

3-24 1981 Pearl River Marshall  
 date well completed from name county well located

LANDOWNER:	description of formations encountered	from	to
<u>Lesley Ford</u>			
<u>Mt. Pleasant, Miss.</u> (mailing address)	<u>Sand</u>	<u>30</u>	<u>150</u>

WELL LOCATION:  
 sec. 8 T. 2 N. R. 3 E.  
5 miles S.W. of Mt. Pleasant  
 (distance) (direction) (nearest town)

WELL PURPOSE: Dwelling  
 (home, irrigation, municipal, industrial)

WELL COMPLETION DATA:

(1) diameter (inches) 4"

(2) total depth (feet) 150

(3) static water level (feet) 70 below above top of ground.

(4) casing PVC, 150 feet  
 (material) (depth)

(size) if telescope see back.

(5) screen 7ft., 143 feet  
 (length) (depth to top)

4", Brownell Well  
 (size) (material)

(6) pump 3/4, 14  
 (HP) (yield gpm)

(type power)

(7) electric log slant  
 (yes or no)

(organization running log)

(8) how well bottom plugged 4' cap.

DRILLERS REMARKS:


DEPT. OF NATURAL RESOURCES  
 BUREAU OF LAND & WATER RESOURCES

APR 9 1981

RECEIVED

If well telescopes please  
sketch and show depths.

GROUND LEVEL

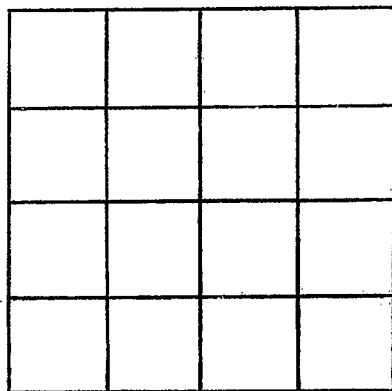

SECTION \_\_\_\_\_

Please indicate well location X.

ADDITIONAL INFORMATION

If more than one screen,  
show locations of each on sketch.