

MISSISSIPPI DEPARTMENT OF NATURAL RESOURCES

Bureau of Land and Water Resources

Southport Mall

P.O. Box 10631

Jackson, Mississippi 39209

WATER WELL DRILLERS LOG

MARSHALL  
F 2036  
4/20/81

4-20-81  
date well completed

Wilson Well Co Inc Marshall  
firm name county well located


LANDOWNER:  
Alexander Gatewood  
RT2 Box 270  
Holly Springs, Miss  
(mailing address)

description of formations encountered	from	to
<u>Red clay - Red Sand</u>	<u>0</u>	<u>30</u>
<u>Red Sand - White clay - Red Sand</u>	<u>30</u>	<u>105</u>
<u>Red Sand</u>	<u>105</u>	<u>125</u>
<u>White clay - White Sand</u>	<u>125</u>	<u>180</u>

WELL LOCATION:  
sec 26 T 2 N. R 3 E  
6 miles (distance) S (direction) of Not Pleasant (nearest town)

WELL PURPOSE: HOME  
(home, irrigation, municipal, industrial)

- WELL COMPLETION DATA:
- (1) diameter (inches) 4
  - (2) total depth (feet) 180
  - (3) static water level (feet) 115 below top of ground.
  - (4) casing Plastic, 170 (material) (depth)  
4 (size) If telescope see back.
  - (5) screen 10' (length) (depth to top)  
4" Plastic (size) (material)
  - (6) pump 3/4 80 (HP) (yield gpm)  
electric (type power)
  - (7) electric log No (yes or no)

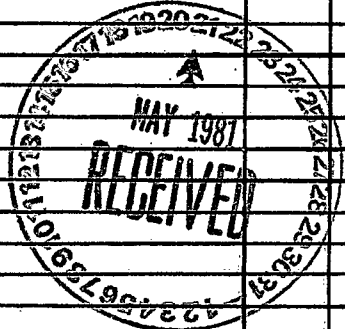


(organization running log)  
(8) how well bottom plugged Plastic Cap 4"

DRILLERS REMARKS:

If well telescopes please sketch and show depths.

GROUND LEVEL

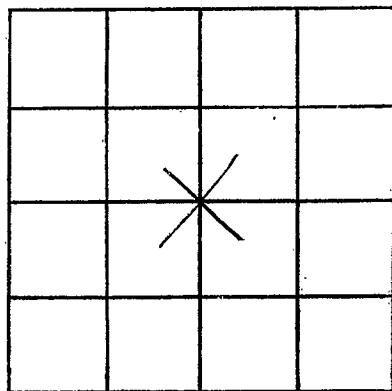

SECTION 26

Please indicate well location X.

ADDITIONAL INFORMATION

If more than one screen,  
show locations of each on sketch.