


MISSISSIPPI DEPARTMENT OF NATURAL RESOURCES
Bureau of Land and Water Resources
 Southport Mall
 P.O. Box 10631
 Jackson, Mississippi 39209
WATER WELL DRILLERS LOG

Marshall
F 2037
6-15-81


6-15 1981 Dean Kent Marshall
 date well completed firm name county well located

LANDOWNER:	description of formations encountered	from	to
<u>Town & county</u> <u>Driller</u>	<u>clay</u>	<u>0</u>	<u>20</u>
<u>Holly Springs, Miss</u> (mailing address)	<u>sand</u>	<u>20</u>	<u>180</u>
WELL LOCATION:			
sec. <u>17</u> T- <u>2</u> N R- <u>3</u> E <u>4</u> miles <u>South</u> of <u>W. Pleasant</u> (distance) (direction) (nearest town)			
WELL PURPOSE: <u>Drilling</u> (home, irrigation, municipal, industrial)			
WELL COMPLETION DATA:			
(1) diameter (inches) <u>4"</u>			
(2) total depth (feet) <u>180 feet</u>			
(3) static water level (feet) <u>100</u> below above top of ground.			
(4) casing <u>PVC</u> <u>180 feet</u> (material) (depth)			
_____ if telescope see back. (size)			
(5) screen <u>7ft.</u> <u>173 feet</u> (length) (depth to top)			
<u>4"</u> <u>gravel wall</u> (size) (material)			
(6) pump <u>3/4</u> <u>14</u> (HP) (yield gpm)			
_____ (type power)			
(7) electric log <u>elect.</u> (yes or no)			
_____ (organization running log)			
(8) how well bottom plugged <u>4" cof</u>			
DRILLERS REMARKS:			

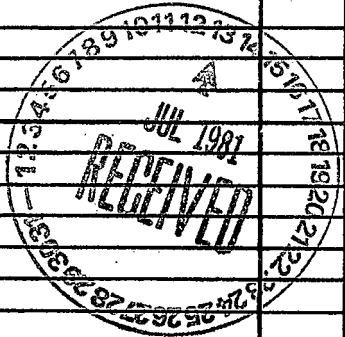

If well telescopes please
sketch and show depths.

GROUND LEVEL

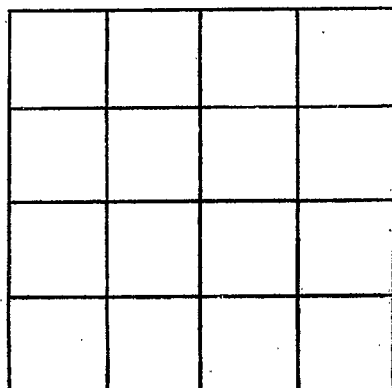

SECTION _____

Please indicate well location X.

ADDITIONAL INFORMATION

If more than one screen,
show locations of each on sketch.