

MISSISSIPPI DEPARTMENT OF NATURAL RESOURCES

Bureau of Land and Water Resources

Southport Mall

P.O. Box 10631

Jackson, Mississippi 39209

WATER WELL DRILLERS LOG

Marshall
F 2038
9-14-81

9-14-81 19
date well completed

Wilson Well Co
firm name

Marshall
county well located

LANDOWNER:
Ann Richmond
RT 1, Box 178
Red Bank, MS
(mailing address)

| description of formations encountered | from | to |
|---------------------------------------|------------|------------|
| <u>Red clay-Red sand</u> | <u>0</u> | <u>30</u> |
| <u>Red sand</u> | <u>30</u> | <u>60</u> |
| <u>white sand-white clay</u> | <u>60</u> | <u>90</u> |
| <u>White clay-white sand</u> | <u>90</u> | <u>105</u> |
| <u>White clay-white sand</u> | <u>105</u> | <u>135</u> |
| <u>White clay-white sand</u> | <u>135</u> | <u>165</u> |

WELL LOCATION:
sec. 16 T 2 N R. 3 E
6 miles S-W of My Pleasant
(distance) (direction) (nearest town)

WELL PURPOSE: Home
(home, irrigation, municipal, industrial)

WELL COMPLETION DATA:
(1) diameter (inches) 4
(2) total depth (feet) 155
(3) static water level (feet) 80 below above top of ground.
(4) casing Plastic (material) (depth)
4 (size) If telescope see back.
(5) screen 10 (length) (depth to top)
4 (size) Plastic (material)
(6) pump 3/4 (HP) 7 (yield gpm)
electric (type power)
(7) electric log No (yes or no)

(organization running log)
(8) how well bottom plugged Plastic Cap 4"

DRILLERS REMARKS:


DEPT. OF NATURAL RESOURCES
BUREAU OF LAND & WATER RESOURCES

OCT 27 1981

RECEIVED

If well telescopes please sketch and show depths.

GROUND LEVEL

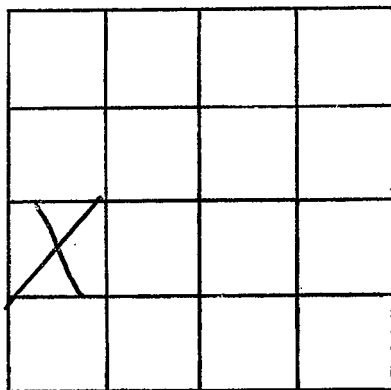

SECTION 16

Please indicate well location X.

ADDITIONAL INFORMATION

If more than one screen,
show locations of each on sketch.