

MISSISSIPPI DEPARTMENT OF NATURAL RESOURCES
Bureau of Land and Water Resources
 Southport Mall
 P.O. Box 10631
 Jackson, Mississippi 39209
WATER WELL DRILLERS LOG

Marshall
F
2039

7-19 1982 Denn Kent Burges Marshall
 date well completed firm name county well located

LANDOWNER:	description of formations encountered	from	to
<u>Mark Jones</u>			
<u>Holly Springs, Miss</u> (mailing address)	<u>Sand</u>	<u>20</u>	<u>210</u>

WELL LOCATION:
 sec. 26 T. 2 N. R. 3 E.
10 miles North of Holly Springs
 (distance) (direction) (nearest town)

WELL PURPOSE: Drilling
 (home, irrigation, municipal, industrial)

- WELL COMPLETION DATA:**
- (1) diameter (inches) 4"
 - (2) total depth (feet) 210 feet
 - (3) static water level (feet) 103 below above top of ground.
 - (4) casing PVC, 210 ft
 (material) (depth)
 (size) if telescope see back.
 - (5) screen 7 ft, 203 feet
 (length) (depth to top)
4", gravel well
 (size) (material)
 - (6) pump 3/4 14
 (HP) (yield gpm)
 (type power)
 - (7) electric log cast
 (yes or no)
 (organization running log)
 - (8) how well bottom plugged 4" col

DRILLERS REMARKS: _____


DEPT. OF NATURAL RESOURCES
 BUREAU OF LAND & WATER RESOURCES

AUG 12 1982

RECEIVED

If well telescopes please
sketch and show depths.

GROUND LEVEL

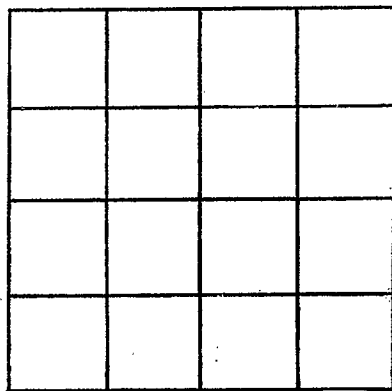

SECTION _____

Please indicate well location X.

ADDITIONAL INFORMATION

If more than one screen,
show locations of each on sketch.