

MISSISSIPPI DEPARTMENT OF NATURAL RESOURCES
 Bureau of Land and Water Resources
 Southport Mall
 P.O. Box 10631
 Jackson, Mississippi 39209
WATER WELL DRILLERS LOG

Marshall
F
2040

5-30 1983 Wilson Well Co. Inc Marshall
 date well completed firm name county well located

LANDOWNER: Lizzie Richmond
Route 2 Box 272
Holly Springs, Miss.
 (mailing address)

description of formations encountered	from	to
<u>Brown Clay</u>	<u>0</u>	<u>30</u>
<u>Brown Clay + pink sand</u>	<u>30</u>	<u>45</u>
<u>White Sand</u>	<u>45</u>	<u>75</u>
<u>White Sand - Red Sand</u>	<u>75</u>	<u>90</u>
<u>White Sand</u>	<u>90</u>	<u>165</u>

WELL LOCATION:
 sec 13 T 2 N R 3 E
0.6 miles SW of Glade
 (distance) (direction) (nearest town)

WELL PURPOSE: Home
 (home, irrigation, municipal, industrial)

WELL COMPLETION DATA:

(1) diameter (inches) 4

(2) total depth (feet) 165

(3) static water level (feet) 85 below above top of ground.

(4) casing Plastic (material), (depth);
4 (size) if telescope see back.

(5) screen 10 (length), (depth to top)
4 (size), Plastic (material)

(6) pump 3/4 (HP) 8 (yield gpm)
Electric (type power)

(7) electric log No (yes or no)
 (organization running log)


(8) how well bottom plugged 4"
Plastic Cap

DRILLERS REMARKS:

DEPT. OF NATURAL RESOURCES
 BUREAU OF LAND & WATER RESOURCES
 JUN 20 1983
RECEIVED

If well telescopes please sketch and show depths.

GROUND LEVEL

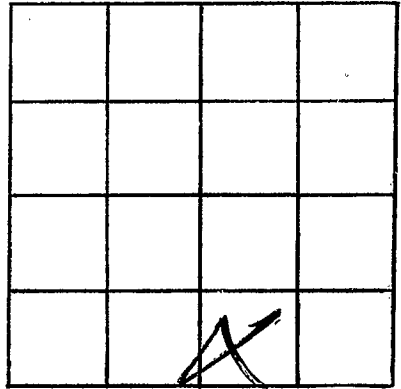

SECTION

LB

Please indicate well location X.

ADDITIONAL INFORMATION

If more than one screen, show locations of each on sketch.