

Marshall  
F  
2041

MISSISSIPPI DEPARTMENT OF NATURAL RESOURCES  
Bureau of Land and Water Resources  
Southport Mall  
P.O. Box 10631  
Jackson, Mississippi 39209  
WATER WELL DRILLERS LOG

HICKS WELL CO.  
P.O. Box 157  
Senatobia, MS 38660

Marshall

8-2 1983  
date well completed

county well located

LANDOWNER: James Gray  
Rt. 2 Box 240B  
Holly Springs Mo. 38635  
(mailing address)

description of formations encountered

from to

WELL LOCATION:  
sec 28 T 2 N R 3 E  
5 miles S of Mt. Pleasant  
(distance) (direction) (nearest town)

|                   |     |     |
|-------------------|-----|-----|
| Red Clay          | 0   | 10  |
| Red Sand          | 10  | 50  |
| White Sand & Clay | 50  | 155 |
| White Sand        | 155 | 170 |

WELL PURPOSE: Home  
(home, irrigation, municipal, industrial)

WELL COMPLETION DATA:  
(1) diameter (inches) 4  
(2) total depth (feet) 170  
(3) static water level (feet) 60 below top of ground.  
(4) casing PVC, 170, (material) (depth)  
4" (size) if telescope see back.  
(5) screen 10', 160' (length) (depth to top)  
.013, PVC (size) (material)  
(6) pump 1/2, 10 (HP) (yield gpm)  
220V (type-power)  
(7) electric log No (yes or no)  
(organization running log)

(8) how well bottom plugged Cap

DRILLERS REMARKS:


DEPT. OF NATURAL RESOURCES  
BUREAU OF LAND & WATER RESOURCES

SEP 22 1983

RECEIVED

If well telescopes please sketch and show depths.

GROUND LEVEL

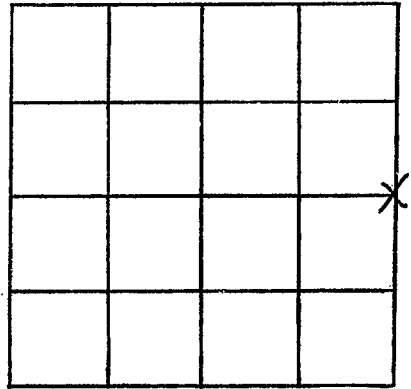

SECTION 28

Please indicate well location X.

ADDITIONAL INFORMATION

If more than one screen,  
show locations of each on sketch.