

MISSISSIPPI DEPARTMENT OF NATURAL RESOURCES

Bureau of Land and Water Resources

Southport Mall

P.O. Box 10631

Jackson, Mississippi 39209

WATER WELL DRILLERS LOG

Marshall
F 242

Jan 14 1983
date well completed

R. L. Carpenter
firm name

Marshall
county well located

LANDOWNER: Jim Williams
Holly Springs, ms
RFD
(mailing address)

description of formations encountered

from to

WELL LOCATION:
sec. 22 2 N 3 E
S W
4 miles South of St Pleasant
(distance) (direction) (nearest town)

<u>Surface Soil</u>	<u>0</u>	<u>15</u>
<u>med. Red Sand</u>	<u>15</u>	<u>42</u>
<u>med. White Sand</u>	<u>42</u>	<u>90</u>
<u>White Fine Sand</u>	<u>90</u>	<u>130</u>
<u>White Clay</u>	<u>130</u>	<u>155</u>
<u>White coarse Sand</u>	<u>155</u>	<u>185</u>

WELL PURPOSE: None
(home, irrigation, municipal, industrial)

- WELL COMPLETION DATA:
- (1) diameter (inches) 4
 - (2) total depth (feet) 185
 - (3) static water level (feet) 118 below top of ground.
 - (4) casing Plasto, 175'
(material) (depth)
(size) If telescope see back.
 - (5) screen 10', 175'
(length) (depth to top)
4", PV
(size) (material)
 - (6) pump 3/4, 12
(HP) (yield gpm)
Elec.
(type power)
 - (7) electric log No.
(yes or no)

(organization running log)
(8) how well bottom plugged PVC caps

DRILLERS REMARKS:


DEPT. OF NATURAL RESOURCES
BUREAU OF LAND & WATER RESOURCES

OCT 20 1984

RECEIVED

If well telescopes please
sketch and show depths.

GROUND LEVEL

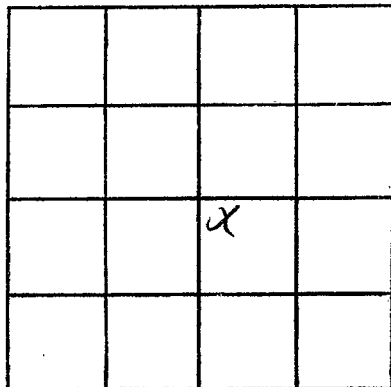

SECTION 22

Please indicate well location X.

ADDITIONAL INFORMATION

If more than one screen,
show locations of each on sketch.