

MISSISSIPPI DEPARTMENT OF NATURAL RESOURCES

Bureau of Land and Water Resources

Southport Mall

P.O. Box 10631

Jackson, Mississippi 39209

WATER WELL DRILLERS LOG

Marshall  
F 2043

Feb. 12 1983  
date well completed

R. L. Carpenter  
firm name

Marshall  
county well located

LANDOWNER: Oscar Pison  
Holly Springs, ms.  
RFD  
(mailing address)

description of formations encountered	from	to
<u>Surface Soil</u>	<u>0</u>	<u>20</u>
<u>red Red Sand</u>	<u>20</u>	<u>45</u>
<u>red white Sand</u>	<u>45</u>	<u>80</u>
<u>white clay</u>	<u>80</u>	<u>128</u>
<u>white coarse Sand</u>	<u>128</u>	<u>158</u>

WELL LOCATION:  
sec. 26 T 2 N R. 3 E  
S W  
15 miles South of W. Plains  
(distance) (direction) (nearest town)

WELL PURPOSE: Home  
(home, irrigation, municipal, industrial)

- WELL COMPLETION DATA:
- (1) diameter (inches) 4
  - (2) total depth (feet) 158
  - (3) static water level (feet) 125 below top of ground.
  - (4) casing Plastic, 148'  
(material) (depth)  
(size) if telescope see back.
  - (5) screen 10', 148'  
(length) (depth to top)  
4", PVC  
(size) (material)
  - (6) pump 3/4, 12  
(HP) (yield gpm)  
Electric  
(type power)
  - (7) electric log No.  
(yes or no)

(organization running log)  
(8) how well bottom plugged PVC cap

DRILLERS REMARKS:


DEPT. OF NATURAL RESOURCES  
BUREAU OF LAND & WATER RESOURCES

OCT 26 1984

RECEIVED

If well telescopes please sketch and show depths.

GROUND LEVEL

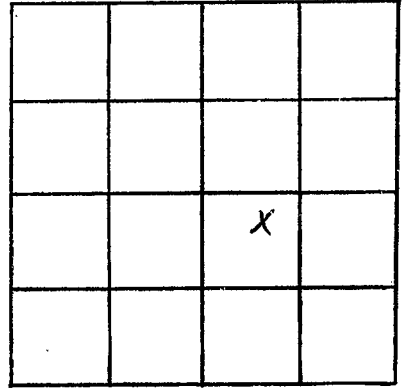

SECTION 26

Please indicate well location X.

ADDITIONAL INFORMATION

If more than one screen,  
show locations of each on sketch.