

MISSISSIPPI DEPARTMENT OF NATURAL RESOURCES
 Bureau of Land and Water Resources
 Southport Mall
 P.O. Box 10631
 Jackson, Mississippi 39209
WATER WELL DRILLERS LOG

Marshall
F 2044

Mar. 7 1983 R. L. Carpenter Marshall
 date well completed firm name county well located

LANDOWNER:	description of formations encountered	from	to
<u>Joe Cunningham</u> <u>Red Bosky Tr.</u>	<u>Surface Soil</u>	<u>0</u>	<u>15</u>
<u>RFD</u> (mailing address)	<u>Med. Red Sand</u>	<u>15</u>	<u>36</u>
WELL LOCATION:	<u>Med. White Sand</u>	<u>36</u>	<u>65</u>
sec. <u>18</u> T. <u>2</u> N R. <u>3</u> E S W	<u>White Clay & Fine Sand</u>	<u>65</u>	<u>84</u>
<u>4</u> miles <u>S</u> of <u>At. Pleasant</u> (distance) (direction) (nearest town)	<u>White coarse sand</u>	<u>84</u>	<u>115</u>
WELL PURPOSE: <u>None</u> (home, irrigation, municipal, industrial)			

- WELL COMPLETION DATA:**
- (1) diameter (inches) 4
 - (2) total depth (feet) 115
 - (3) static water level (feet) 65 below above top of ground.
 - (4) casing Plastic, 114'
(material) (depth)
(size) if telescope see back.
 - (5) screen 10', 114'
(length) (depth to top)
4", PVC
(size) (material)
 - (6) pump 1/2, 10
(HP) (yield gpm)
Eden
(type power)
 - (7) electric log no
(yes or no)
(organization running log)
 - (8) how well bottom plugged PVC cap

DRILLERS REMARKS:


DEPT. OF NATURAL RESOURCES
 BUREAU OF LAND & WATER RESOURCES

OCT 26 1984

RECEIVED

If well telescopes please sketch and show depths.

GROUND LEVEL

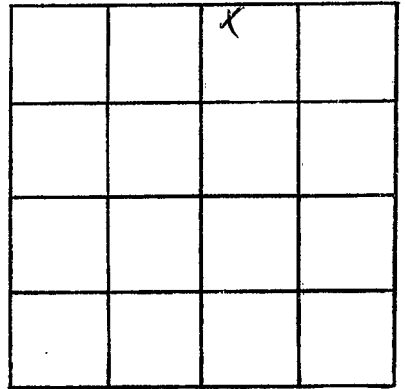

SECTION 18

Please indicate well location X.

ADDITIONAL INFORMATION

If more than one screen,
show locations of each on sketch.