

Marshall
F
2095

MISSISSIPPI DEPARTMENT OF NATURAL RESOURCES
Bureau of Land and Water Resources
Southport Mall
P.O. Box 10631
Jackson, Mississippi 39209
WATER WELL DRILLERS LOG

9-7-1984 date well completed Wilsow Well Co. Inc. firm name Marshall county well located

LANDOWNER: Tom Maroney
Aug 311
Holly Springs, Ms.
(mailing address)

description of formations encountered	from	to
Red Clay - Red Sand	0	20
White Clay	20	98
White Sand	98	150

WELL LOCATION:
sec 22 T 2 N R 3 E
S S of Mt Pleasant
(distance) (direction) (nearest town)

WELL PURPOSE: none
(home, irrigation, municipal, industrial)

- WELL COMPLETION DATA:
- (1) diameter (inches) 4
 - (2) total depth (feet) 147
 - (3) static water level (feet) 120 below above top of ground.
 - (4) casing Plastic, 147,
(material) (depth)
4 if telescope see back.
(size)
 - (5) screen 10, (depth to top)
(length)
4, Plastic
(size) (material)
 - (6) pump 3/4, 12
(HP) (yield gpm)
Elec.
(type power)
 - (7) electric log NO
(yes or no)
(organization running log)
 - (8) how well bottom plugged 4-Prillag

DEPT. OF NATURAL RESOURCES
BUREAU OF LAND & WATER RESOURCES


OCT 25 1984

RECEIVED

DRILLERS REMARKS:

If well telescopes please
sketch and show depths.

GROUND LEVEL

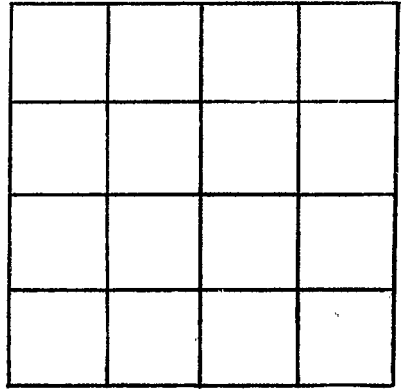

SECTION _____

Please indicate well location X.

ADDITIONAL INFORMATION

If more than one screen,
show locations of each on sketch.