

MISSISSIPPI DEPARTMENT OF NATURAL RESOURCES

Bureau of Land and Water Resources

Southport Mall

P.O. Box 10631

Jackson, Mississippi 39209

WATER WELL DRILLERS LOG

MARSHALL
F 2046

5-18 19 **85**
 date well completed

Larry Carpenter Wells **Marshall**
 firm name county well located

LANDOWNER: **Billy Howell**

description of formations encountered

from

to

Holly Springs
ms. RFD
 (mailing address)

Surface Soil 0 12

Red Brown Sand 12 30

Red. White Sand 30 60

White Coarse Sand 60 95

WELL LOCATION:

sec. **7** T. **2** N R. **3** E
5 miles **South** of **Jackson**
 (distance) (direction) (nearest town)

WELL PURPOSE: **Home**
 (home, irrigation, municipal, industrial)

WELL COMPLETION DATA:

(1) diameter (inches) **4**

(2) total depth (feet) **95**

(3) static water level (feet) **15** below above top of ground.

(4) casing **PVC** **85'**
 (material) (depth)

(size) if telescope see back.

(5) screen **16'** **85'**
 (length) (depth to top)

Home **PVC**
 (size) (material)

(6) pump **1/2** **12**
 (HP) (yield gpm)


Electric
 (type power)

(7) electric log **No**
 (yes or no)

(organization running log)

(8) how well bottom plugged **PVC cap**


DRILLERS REMARKS:

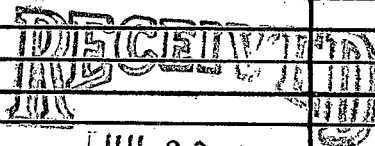

Department of Natural Resources
 Bureau of Land & Water Resources

If well telescopes please sketch and show depths.

GROUND LEVEL

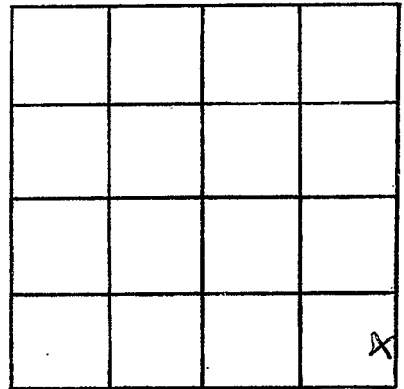

SECTION 21

Please indicate well location X.

ADDITIONAL INFORMATION

If more than one screen, show locations of each on sketch.