

MISSISSIPPI DEPARTMENT OF NATURAL RESOURCES
Bureau of Land and Water Resources
 Southport Mall
 P.O. Box 10631
 Jackson, Mississippi 39209
WATER WELL DRILLERS LOG

MARSHALL
F
2047

5-23 19**85** Long Carpenter Well Co. Marshall
 date well completed firm name county well located

LANDOWNER: Curtis Hester

Red Bank, Ms.

RFD

(mailing address)

WELL LOCATION:

sec. 20 T 2 N R. 30 E
3 1/2 miles SW of Waltham
 (distance) (direction) (nearest town)

WELL PURPOSE: None
 (home, irrigation, municipal, industrial)

WELL COMPLETION DATA:

- (1) diameter (inches) 4
- (2) total depth (feet) 135
- (3) static water level (feet) 85 below above top of ground.
- (4) casing PVC, 125'
 (material) (depth)
 (size) if telescope see back.
- (5) screen 18', 125'
 (length) (depth to top)
4 in., PVC
 (size) (material)
- (6) pump 1/2, 10
 (HP) (yield gpm)
3 hp
 (type power)
- (7) electric log no
 (yes or no)

(organization running log)

(8) how well bottom plugged PVC Cap

description of formations encountered	from	to
<u>Surface Soil</u>	<u>0</u>	<u>20</u>
<u>Med. Red Sand</u>	<u>20</u>	<u>38</u>
<u>White Coarse Sand</u>	<u>38</u>	<u>65</u>
<u>White Clay</u>	<u>65</u>	<u>75</u>
<u>Fine white Sand</u>	<u>75</u>	<u>90</u>
<u>White Coarse Sand</u>	<u>90</u>	<u>135</u>


RECEIVED
 JUL 25 1981

Mississippi Department of Natural Resources
 Bureau of Land & Water Resources

DRILLERS REMARKS:

If well telescopes please
sketch and show depths.

GROUND LEVEL

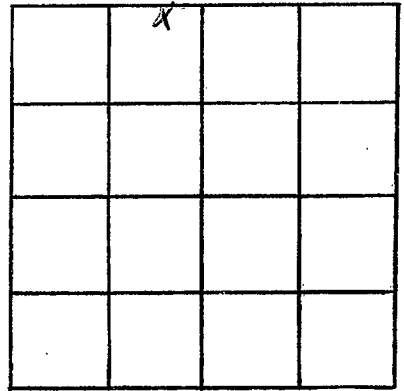

SECTION 20

Please indicate well location X.

ADDITIONAL INFORMATION

If more than one screen,
show locations of each on sketch.