

MISSISSIPPI DEPARTMENT OF NATURAL RESOURCES

Bureau of Land and Water Resources

Southport Mall

P.O. Box 10631

Jackson, Mississippi 39209

WATER WELL DRILLERS LOG

MARSHALL
P 2048

6-13 1985 Larry Carpenter Well Co. Marshall
date well completed firm name county well located

LANDOWNER: Heber Stickleland
Red Banks, ms
RFD
(mailing address)

WELL LOCATION:
sec. 8 T. 2 N. R. 3 E
2 miles SW of Mt. Pleasant
(distance) (direction) (nearest town)

WELL PURPOSE: Home
(home, irrigation, municipal, industrial)

WELL COMPLETION DATA:

- (1) diameter (inches) 4
- (2) total depth (feet) 125
- (3) static water level (feet) 70 below above top of ground.
- (4) casing PVC, 115'
(material) (depth)
(size) if telescope see back.
- (5) screen 18', 115'
(length) (depth to top)
4 in., PVC
(size) (material)
- (6) pump 1/2, 10
(HP) (yield gpm)
Elec.
(type power)
- (7) electric log No
(yes or no)
(organization running log)
- (8) how well bottom plugged PVC cap

DRILLERS REMARKS:

description of formations encountered	from	to
<u>Surface Soil</u>	<u>0</u>	<u>22</u>
<u>Med Red Sand + Red Clay</u>	<u>22</u>	<u>50</u>
<u>Med. white Sand</u>	<u>50</u>	<u>80</u>
<u>White Clay</u>	<u>80</u>	<u>95</u>
<u>White med. + coarse Sand</u>	<u>95</u>	<u>125</u>


RECEIVED

JUL 23 1986

Department of Natural Resources
Bureau of Land & Water Resources

If well telescopes please
sketch and show depths.

GROUND LEVEL

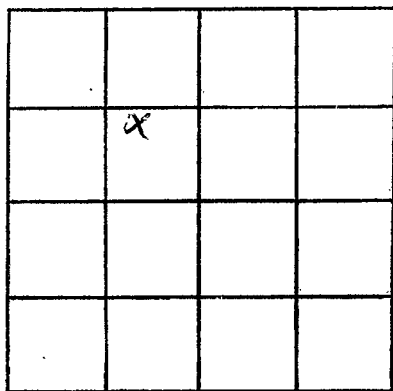

SECTION 8

Please indicate well location X.

ADDITIONAL INFORMATION

If more than one screen,
show locations of each on sketch.