

Marshall
G 2,
3-20-69

MISSISSIPPI
BOARD OF WATER COMMISSIONERS
416 North State Street
Jackson, Mississippi

CODED

WATER WELL DRILLERS LOG

3-20-69 date well completed
Wilson Well Co. name
Marshall county well located

LANDOWNER: Amel Pearson
Lamar Armin
RFD 1
(mailing address)

description of formations encountered	from	to
Yellow Clay	0	15
Red Sand	15	75
White Sand	75	105
White Clay	105	120
Water Sand	120	185

WELL LOCATION:
sec 27 T 2 R 2
3 1/2 miles West of Hudsonville
(distance) (direction) (nearest town)

WELL PURPOSE: Home
(home, irrigation, municipal, industrial)

WELL COMPLETION DATA:

(1) diameter (inches) H

(2) total depth (feet) 185

(3) static water level (feet) 135 below above top of ground.

(4) casing Plastic, 185
(material) (depth)

(size) if telescope see back.

(5) screen 8, 185
(length) (depth to top)

H, 2 1/2"
(size) (material)

(6) pump 3/4, 10
(HP) (yield gpm)

E
(type power)

(7) electric log no
(yes or no)

CODED

(organization running log)

(8) how well bottom plugged cap


MAY 19 1969

MISS. BD. OF
WATER COMMISSIONERS

DRILLERS REMARKS:

If well telescopes please
sketch and show depths.

GROUND LEVEL

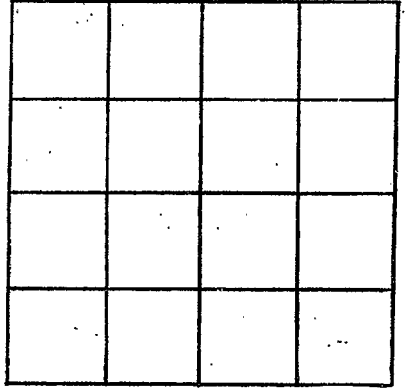

SECTION 27

Please indicate well location X.

ADDITIONAL INFORMATION

If more than one screen,
show locations of each on sketch.