

Marshall  
G 3  
5-69

MISSISSIPPI  
BOARD OF WATER COMMISSIONERS  
416 North State Street  
Jackson, Mississippi 39201

**CODED**

WATER WELL DRILLERS LOG

May 19 1969 date well completed  
Robert W. Wilson firm name  
Marshall county well located

LANDOWNER: Luther Mathews  
Forrest Hill Rd

description of formations encountered	from	to
Red Clay Red Sand	0	20
White Clay Red Sand	20	40
Red Sand	40	80
Red Sand White Clay Red Sand	80	100
Red Sand	100	180
White Sand White Clay White Sand	180	200
White Sand	200	220

Mermentau TOWN.  
(mailing address)

WELL LOCATION:  
sec. 25 T. 2 N. R. 2 E. S. W  
(distance) miles of (direction) of (nearest town)

WELL PURPOSE:  
(Home, irrigation, municipal, industrial)

WELL COMPLETION DATA:

- (1) diameter (inches) 4
- (2) total depth (feet) 220
- (3) static water level (feet) 180 below above top of ground.
- (4) casing Plastic, 216,  
(material) (depth)  
4"  
(size) If telescope see back.
- (5) screen 4', 216  
(length) (depth to top)  
4", MANUEL PACK  
(size) (material)
- (6) pump 1HP 18  
(HP) (yield gpm)  
Electric  
(type power)
- (7) electric log yes or no   
(organization running log)
- (8) how well bottom plugged 4"  
Plastic cap

**CODED**

AUG 6 1969

MISS. BD. OF  
WATER COMM.


1969

DRILLERS REMARKS:

MISS. BD. OF  
WATER COMM.

If well telescopes please sketch and show depths.

GROUND LEVEL

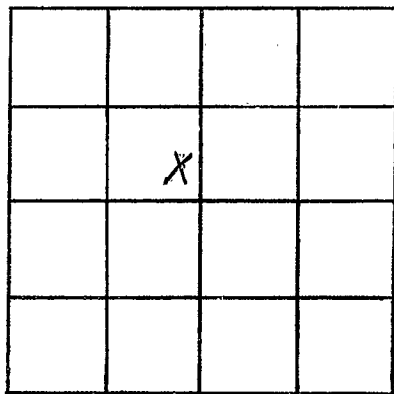

SECTION 25

Please indicate well location X.

ADDITIONAL INFORMATION

If more than one screen,  
show locations of each on sketch.