

MARSHALL
G 4.
7-17-69

MISSISSIPPI
BOARD OF WATER COMMISSIONERS
416 North State Street
Jackson, Mississippi 39201

CODED

WATER WELL DRILLERS LOG

7-17-69 date well completed Dumpes Well Co. firm name Marshall county well located

LANDOWNER:
Roberts Chapple
Church, Hayden W. Jr.
(mailing address)

description of formations encountered	from	to
	<u>clay</u>	<u>0</u>
<u>Sand</u>	<u>20</u>	<u>160</u>

WELL LOCATION:
sec 26 T 2 N R 2 E
2 miles S East of Stuy
(distance) (direction) (nearest town)

WELL PURPOSE:
(home, irrigation, municipal, industrial)

- WELL COMPLETION DATA:
- (1) diameter (inches) 4"
 - (2) total depth (feet) 160 feet
 - (3) static water level (feet) 130 below above top of ground.
 - (4) casing PVC, 160 feet
(material) (depth)
 if telescope see back.
(size)
 - (5) screen 6 ft., 154 feet
(length) (depth to top)
4", gravel wall
(size) (material)
 - (6) pump 3/4, 10
(HP) (yield gpm)

(type power)
 - (7) electric log elect.
(yes or no)

(organization running log)
 - (8) how well bottom plugged 4" cap.

CODED


DEC - 1 1969

MISS. BD. OF
WATER COMMISSIONERS

DRILLERS REMARKS:

If well telescopes please sketch and show depths.

GROUND LEVEL

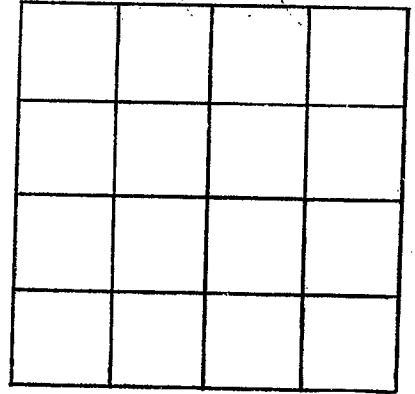

SECTION _____

Please indicate well location X.

ADDITIONAL INFORMATION

If more than one screen, show locations of each on sketch.